

DEC 7 1978 STATE OF OREGON

(Please type or print)

ate
WATER RESOURCES DEPT.
(Do not write above this line)
SALEM, OREGON

State Well No. 11512070

State Permit No. 6-8893



Oregon Water Resources Department
725 Summer Street NE, Suite A
Salem Oregon 97301
(503) 986-0900
www.oregon.gov/owrd

Application for Well ID Number

RECEIVED

JUL 24 2023

OWRD

Do not complete if the well already has a Well Identification Number.

I. OWNER INFORMATION

Current Owner Name (please print): Michael Weaver
Mailing Address: 3597 NW Goldfinch Pl
City, State, Zip: Corvallis OR 97330
Mail Well ID to: ☒ SAME AS ABOVE ☐ In Care Of (C/O)
Name & Address: _____
City, State, Zip: _____

II. WELL LOCATION INFORMATION (Please fill out as completely as possible)

Township: 11 S (North / South) Range: 5 W (East / West) Section: 10 NW 1/4 of the SW 1/4
Tax Lot (usually last 3-5 numbers of Tax Map #): 2300 County Benton
GPS Coordinates: 44.62584 -123.28716 per property survey 7-3-23
Street Address of Well, City: 2320 NW Huntington Dr Corvallis OR 97330
If the property had a different street address in the past: _____

III. GENERAL WELL INFORMATION (Please fill out as completely as possible, AND attach copy of Well Report, if available)

Use of Well (domestic, irrigation, commercial, industrial, monitoring): domestic
Date Well Constructed (or property built): 11-21-78 Total Well Depth: 225' Casing Diameter: 6"
Owner at time the well was constructed (if known): Ron Cameron Well Report # (if known): BENT 3218
Other Information: water right certificate 61091

SUBMITTED BY (please print): Michael Weaver
PHONE: 541-936-5011 EMAIL &/or FAX: mike@mwelectricinc.com

To send the completed application, you may MAIL it to: Oregon Water Resources Dept. 725 Summer St NE, Suite A, Salem, Oregon 97301.
Or EMAIL the completed PDF form to: Ladeena.K.Ashley@water.oregon.gov, or FAX it to: (503) 986-0902.

For Official Use Only by the Oregon Water Resources Department:


Received Date:
7-24-2023

Well Report Number:
BENT 3218

Well Identification #:
L-151837

RECEIVED
JUL 25 2023
OWRD

OWRD STAFF NOTES: This survey map submitted as a supplement to show approximate well locations only, WRD does not guarantee accuracy.

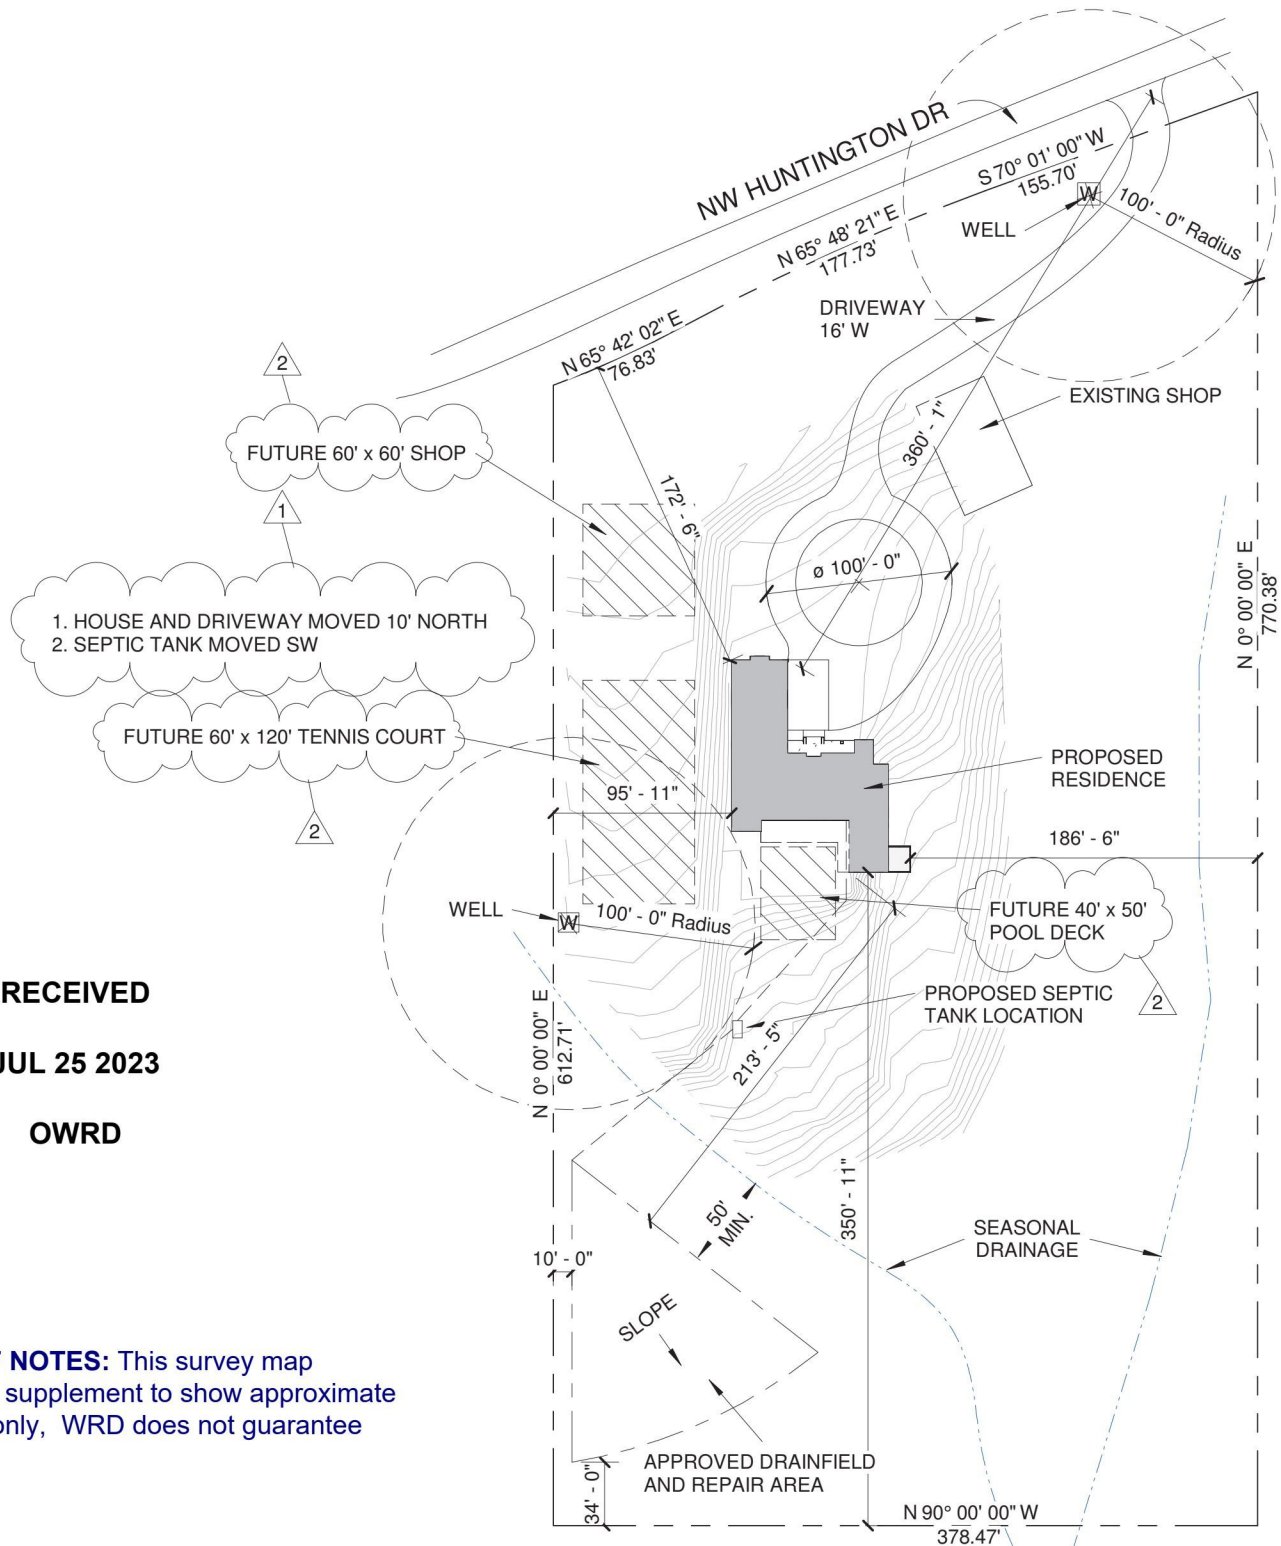

Site Plan

1" = 80'-0"

MAP 11-3-10 C TL 2300