

STATE OF OREGON
WATER WELL REPORT
(as required by ORS 537.765)

BENT 730

(START CARD) # 22810

155/bw/2dd

(1) OWNER: Well Number: 646
Name James Crawford
Address P.O. Box 408
City Hamilton State WA Zip 98255

(2) TYPE OF WORK:
☒ New Well ☐ Deepen ☐ Recondition ☐ Abandon

(3) DRILL METHOD
☒ Rotary Air ☐ Rotary Mud ☐ Cable
☐ Other

(4) PROPOSED USE:
☒ Domestic ☐ Community ☐ Industrial ☐ Irrigation
☐ Thermal ☐ Injection ☐ Other

(5) BORE HOLE CONSTRUCTION:
Special Construction approval Yes ☐ No ☒ Depth of Completed Well 395 ft.
Explosives used Yes ☐ No ☒ Type Amount

HOLE		SEAL		Amount	
Diameter	From To	Material	From To	sacks or pounds	
10"	0' 59'	Cement	0' 59'	12 Sacks	
6"	59' 395'				

How was seal placed: Method ☐ A ☐ B ☒ C ☐ D ☐ E
☐ Other
Backfill placed from _____ ft. to _____ ft. Material _____
Gravel placed from _____ ft. to _____ ft. Size of gravel _____

(6) CASING/LINER:

Diameter	From	To	Gauge	Steel	Plastic	Welded	Threaded
Casing: 6"	0'	59'	250	☒	☐	☒	☐
Liner: 4"	0'	395'	160	☐	☒	☐	☐

Final location of shoe(s) 59 ft

(7) PERFORATIONS/SCREENS:
☒ Perforations Method Elect Saw
☐ Screens Type Material

From	To	Slot size	Number	Diameter	Tele/pipe size	Casing	Liner
120'	395'	8x5	280			☐	☒
Shale Trap placed at 100 ft.							

(8) WELL TESTS: Minimum testing time is 1 hour
☐ Pump ☐ Bailer ☒ Air ☐ Flowing ☐ Artesian
Yield gal/min 8 GPM Drawdown _____ Drill stem at 395' Time 1 hr.

Temperature of water 53° Depth Artesian Flow Found _____
Was a water analysis done? ☐ Yes By whom _____
Did any strata contain water not suitable for intended use? ☐ Too little
☐ Salty ☐ Muddy ☐ Odor ☐ Colored ☐ Other _____
Depth of strata: _____

(9) LOCATION OF WELL by legal description:

County Benton Latitude _____ Longitude _____
Township 15S N or S, Range 6W E or W, WM.
Section 2 SE 1/4 SE 1/4
Tax Lot 801 Lot _____ Block _____ Subdivision _____
Street Address of Well (or nearest address) 24155 Hewitt Rd.
Alpine

(10) STATIC WATER LEVEL:

103 ft. below land surface. Date 5/28/91
Artesian pressure _____ lb. per square inch. Date _____

(11) WATER BEARING ZONES:

From	To	Estimated Flow Rate	SWL
125'	126'	2 GPM	103
237'	238'	3 GPM	103
344'	345'	3 GPM	103

(12) WELL LOG:

Material	From	To	SWL
Topsail	0	3	0
Brown Clay	3	6	0
Red Clay	6	21	0
Grey Clay	21	35	0
Yellow Clay	35	52	0
Grey Shale	52	71	0
Yellow Claystone	71	82	0
Grey Shale	82	193	103
Grey Sandstone	193	198	103
Grey Shale	198	347	103
Grey Sandstone	347	395	103

RECEIVED

JUN 28 1991

WATER RESOURCES DEPT.
SALEM, OREGON

Date started 5/25/91 Completed 5/28/91

(unbonded) Water Well Constructor Certification:

I certify that the work I performed on the construction, alteration, or abandonment of this well is in compliance with Oregon well construction standards. Materials used and information reported above are true to my best knowledge and belief.

Signed _____ WWC Number 1411
Date _____

(bonded) Water Well Constructor Certification:

I accept responsibility for the construction, alteration, or abandonment work performed on this well during the construction dates reported above. all work performed during this time is in compliance with Oregon well construction standards. This report is true to the best of my knowledge and belief.

Signed Donald J. Forring WWC Number 751
Date 5/29/91



Oregon Water Resources Department
725 Summer Street NE, Suite A
Salem Oregon 97301
(503) 986-0900
www.wrd.state.or.us

Application for Well ID Number

RECEIVED

MAR 11 2016

WATER RESOURCES DEPT
SALEM, OREGON

Do not complete if the well already has a Well Identification Number.

I. OWNER INFORMATION

Current Owner Name (please print): Jared Dellinger & Andrew Felperin

Mailing Address: 24155 Hewett Road

City, State, Zip: Monroe, OR 97456

Mail Well ID Tag to: ☒ SAME AS ABOVE ☐ In Care Of (C/O)

Name & Address: L120348

City, State, Zip:

II. WELL LOCATION INFORMATION (Please fill out as completely as possible)

Township: 15S (North / South) Range: 6W (East / West) Section: 02 1/4 of the 1/4

Tax Lot (usually last 3-5 numbers of Tax Map #): 801 County Benton

GPS Coordinates: Latitude 44.290515147 Longitude -123.3743806

Street Address of Well, City: 24155 Hewett Road, Monroe, OR 97456

If the property had a different street address in the past:

III. GENERAL WELL INFORMATION (Please fill out as completely as possible, AND attach copy of Well Log, if available)

Use of Well (domestic, irrigation, commercial, industrial, monitoring): Domestic

Date Well Constructed (or property built): 1992 House & 1978 Cabin Total Well Depth: Casing Diameter: 6"

Owner at time the well was constructed (if known): Well Log # (if known):

Other Information:

SUBMITTED BY (please print): Robert N. Turkisher (Benton County Environmental Health)

PHONE: 541-766-6841 EMAIL &/or FAX: 541-766-6248

Send application to: Oregon Water Resources Department 725 Summer St NE, Suite A, Salem, Oregon 97301; or fax to (503) 986-0902.
Applications are processed in the order they are received, and Well ID Numbers are mailed within 4-5 business days.

For Official Use Only by the Oregon Water Resources Department:

Received Date:

3-11-16

Well Log Number:

BENT 730

Well Identification #:

2-120348

BENT 730



BENTON COUNTY ENVIRONMENTAL HEALTH ON-SITE SEWAGE DISPOSAL SYSTEM PLOT PLAN

Owner: Jared Dellinger & Andrew Felperin

Date: 03/11/16

SITE #: -
PERMIT: -
TYPE: Property Line Adjustment


Applicant: N/A

Assessor's Map and Tax Lot Numbers: 15-6-2 TL 801

Address: 24155 Hewett Road, Monroe, OR 97456

Parcel: 20.23 Acres

Scale: 1 inch = 200 feet

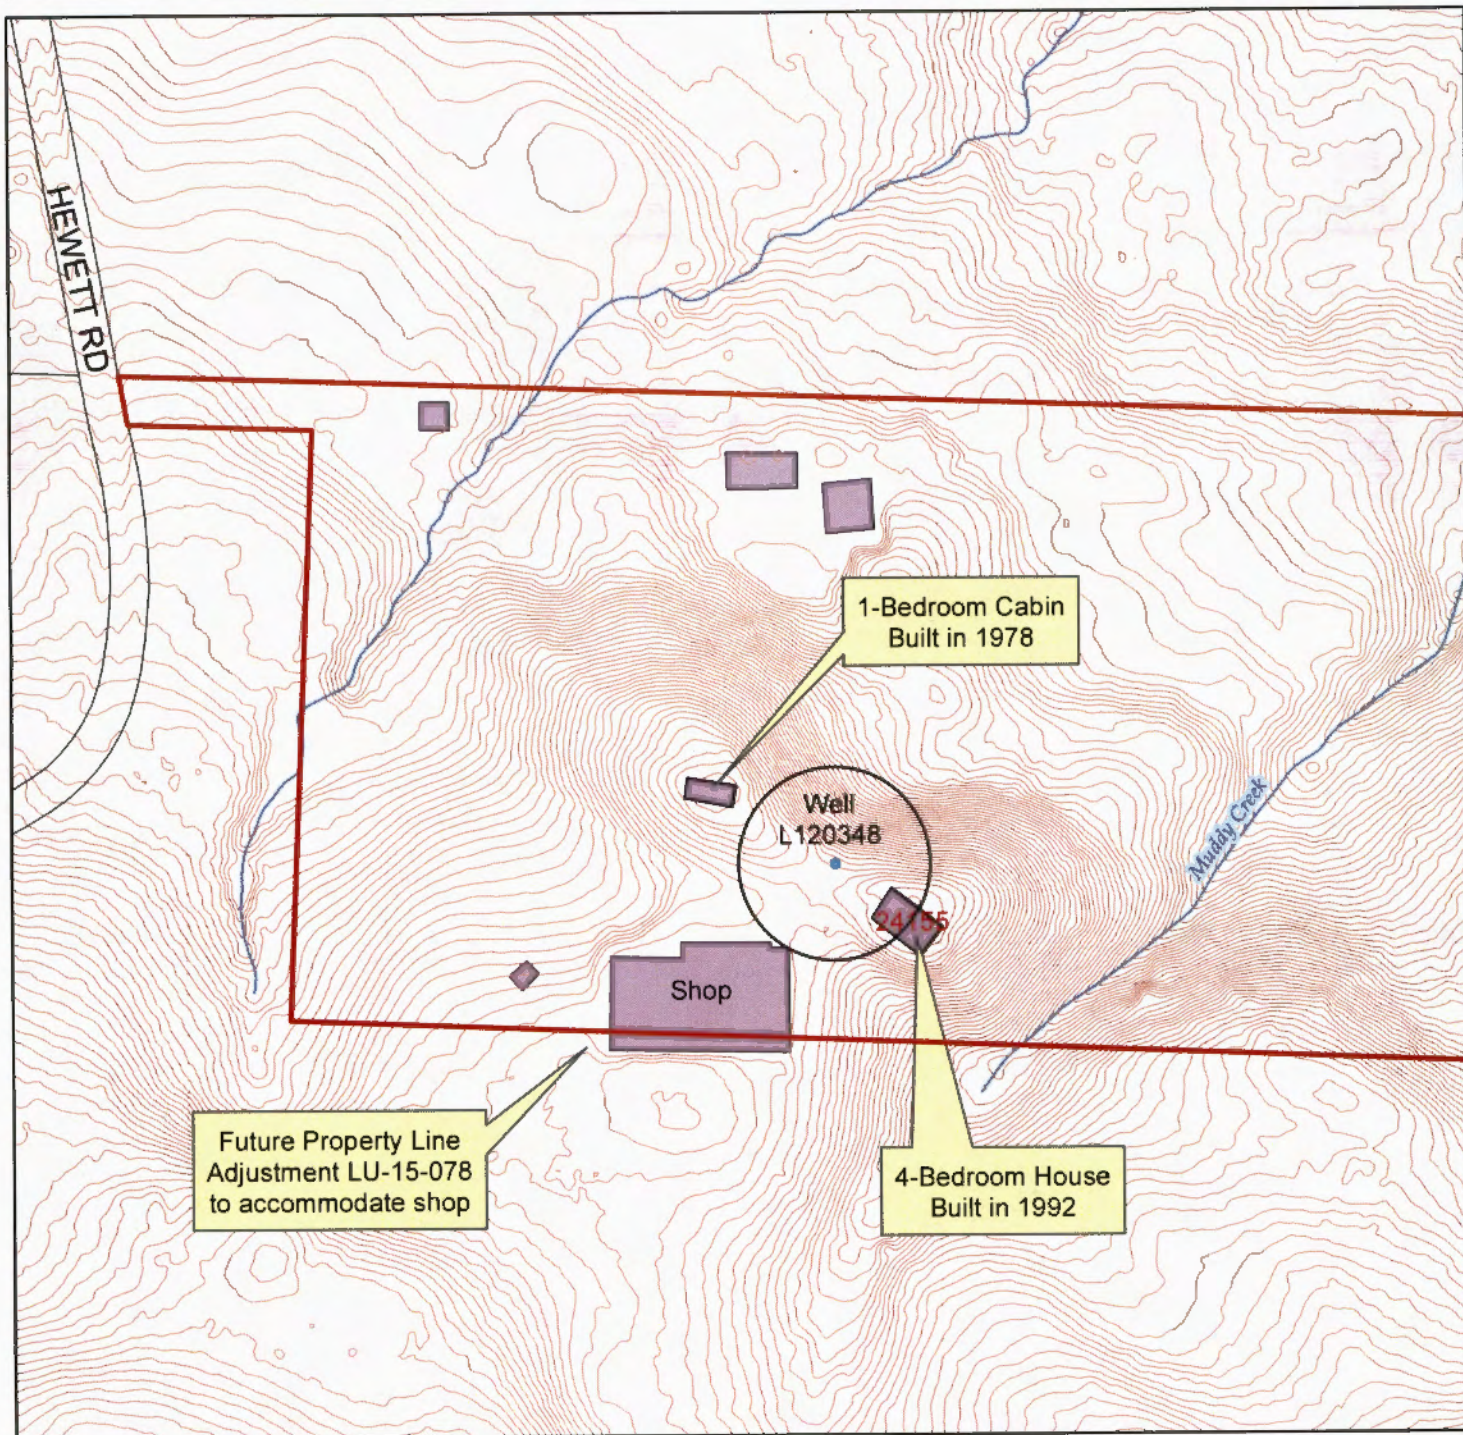

RECEIVED

MAR 11 2016

WATER RESOURCES DEPT
SALEM, OREGON

