

JACK 14479
State Well No. 38s/1W-1dc
State Permit No. _____

(1) OWNER:

Name James Adams
Address Habit, Oregon

(2) TYPE OF WORK (check):

New Well Deepening Reconditioning Abandon
If abandonment, describe material and procedure in Item 12.

(3) TYPE OF WELL:

Rotary Cable Dug
Driven Jetted Bored

(4) PROPOSED USE (check):

Domestic Industrial Municipal
Irrigation Test Well Other

(10) LOCATION OF WELL:

County Jackson Driller's well number _____
S.W. 1/4, S.E. 1/4 Section 1 T. 38S R. 1 W. W.M.
Bearing and distance from section or subdivision corner _____

(11) WATER LEVEL: Completed well.

Depth at which water was first found 102 ft.
Static level 2 ft. below land surface. Date 7-29-72
Artesian pressure _____ lbs. per square inch. Date _____

(12) WELL LOG:

Diameter of well below casing 2.45
Depth drilled 245 ft. Depth of completed well 7-29 ft.
Formation: Describe color, texture, grain size and structure of materials; and show thickness and nature of each stratum and aquifer penetrated, with at least one entry for each change of formation. Report each change in position of Static Water Level and indicate principal water-bearing strata.

| MATERIAL | From | To | SWL |
|----------------------------|------|-----|-----|
| Soil | 0 | 3 | — |
| Clay | 3 | 9 | — |
| Conglomerate (hard) | 9 | 27 | — |
| Sandstone | 27 | 43 | — |
| Conglomerate (loose, hard) | 43 | 99 | — |
| Serpentine (green) | 99 | 101 | — |
| Conglomerate (hard) | 101 | 125 | 2 |
| Sandstone (light gray) | 125 | 132 | 2 |
| Conglomerate (hard) | 132 | 165 | 2 |
| Sandstone (brown) | 165 | 177 | 2 |
| Conglomerate (hard) | 177 | 189 | 2 |
| Sandstone | 189 | 245 | 2 |

Work started July 20 1972 Completed July 29 1972
Date well drilling machine moved off of well July 31 1972

Drilling Machine Operator's Certification:

This well was constructed under my direct supervision. Materials used and information reported above are true to my best knowledge and belief.

[Signed] E. J. Stadelbauer Date 7-31-72
(Drilling Machine Operator)

Drilling Machine Operator's License No. 261

Water Well Contractor's Certification:

This well was drilled under my jurisdiction and this report is true to the best of my knowledge and belief.

Name E. J. Stadelbauer
(Person, firm, or corporation) (Type or print)

Address 55 W. Nevada St. - Portland

[Signed] E. J. Stadelbauer
(Water Well Contractor)

Contractor's License No. 40 Date 7-31, 1972

(5) CASING INSTALLED:

Threaded Welded
6" Diam. from 0 ft. to 34 ft. Gage 1250
" Diam. from _____ ft. to _____ ft. Gage _____
" Diam. from _____ ft. to _____ ft. Gage _____

(6) PERFORATIONS:

Perforated? Yes No
Type of perforator used none
Size of perforations in. by in.
perforations from _____ ft. to _____ ft.
perforations from _____ ft. to _____ ft.
perforations from _____ ft. to _____ ft.

(7) SCREENS:

Well screen installed? Yes No
Manufacturer's Name _____
Type _____ Model No. _____
Diam. _____ Slot size _____ Set from _____ ft. to _____ ft.
Diam. _____ Slot size _____ Set from _____ ft. to _____ ft.

(8) WELL TESTS:

Drawdown is amount water level is lowered below static level
Was a pump test made? Yes No If yes, by whom?
Yield: gal./min. with ft. drawdown after hrs.
" " " " " "
" " " " " "
Bailer test 6 gal./min. with 230 ft. drawdown after 1 hrs.
Artesian flow _____ g.p.m.
Temperature of water 60 Depth artesian flow encountered _____ ft.

(9) CONSTRUCTION:

Well seal—Material used Concrete, 3 to 1 mix
Well sealed from land surface to 33 ft.
Diameter of well bore to bottom of seal 10 in.
Diameter of well bore below seal 6 in.
Number of sacks of cement used in well seal 3 sacks
Number of sacks of bentonite used in well seal _____ sacks
Brand name of bentonite _____
Number of pounds of bentonite per 100 gallons of water _____ lbs./100 gals.
Was a drive shoe used? Yes No Plugs _____ Size: location _____ ft.
Did any strata contain unusable water? Yes No
Type of water? good depth of strata 102-240
Method of sealing strata off _____
Was well gravel packed? Yes No Size of gravel: _____
Gravel placed from _____ ft. to _____ ft.



Oregon Water Resources Department
725 Summer Street NE, Suite A
Salem Oregon 97301
(503) 986-0900
www.oregon.gov/owrd

Application for
Well ID Number

RECEIVED

OCT 10 2019

OWRD

Do not complete if the well already has a Well Identification Number.

I. OWNER INFORMATION

Current Owner Name (please print): Fern Valley Estates Improvement District, (Well No.5)
Mailing Address: 2387 Terri Drive
City, State, Zip: Medford, OR 97504
Mail Well ID to: [] SAME AS ABOVE [X] In Care Of (C/O)
Name & Address: Harold L. Center, President FVEID
City, State, Zip: 2604 David Lane, Medford, OR 97504

II. WELL LOCATION INFORMATION (Please fill out as completely as possible)

Township: 38 South (North / South) Range: 1 West (East / West) Section: 2 SE 1/4 of the SE 1/4
Tax Lot (usually last 3-5 numbers of Tax Map #): 200 County Jackson
GPS Coordinates: 42d 17' 26.39" N 122d 46' 38.86" W
Street Address of Well, City: 3081 Payne Road, Medford, Or 97504
If the property had a different street address in the past: Talent, OR on well log Jack 14479

III. GENERAL WELL INFORMATION (Please fill out as completely as possible, AND attach copy of Well Report, if available)

Use of Well (domestic, irrigation, commercial, industrial, monitoring): Domestic
Date Well Constructed (or property built): 7/31/1972 Total Well Depth: 364* Casing Diameter: 6" JACK
Owner at time the well was constructed (if known): Jim Adams/FVEID Well Report # (if known): Jack 14479/30448
Other Information: * well deepened to 364', see Jack 30448

SUBMITTED BY (please print): Harold L. Center, President FVEID
PHONE: 541-535-6108 EMAIL &/or FAX: center1071@gmail.com

Send application to: Oregon Water Resources Department 725 Summer St NE, Suite A, Salem, Oregon 97301; or fax to (503) 986-0902.
Applications are processed in the order they are received, and Well ID Numbers are mailed within 4-5 business days.

For Official Use Only by the Oregon Water Resources Department:
Received Date: 10-10-19 Well Report Number: JACK 14479 + JACK 30448 Well Identification #: L-135928
- ORIG - - DEEPENED -

FOR ASSESSMENT AND
TAXATION ONLY


JACK 14479

SECTION 1 T.38S. R.1W. W.M.
JACKSON COUNTY

381W1

1" = 400'

RECEIVED
OCT 10 2019
OWRD

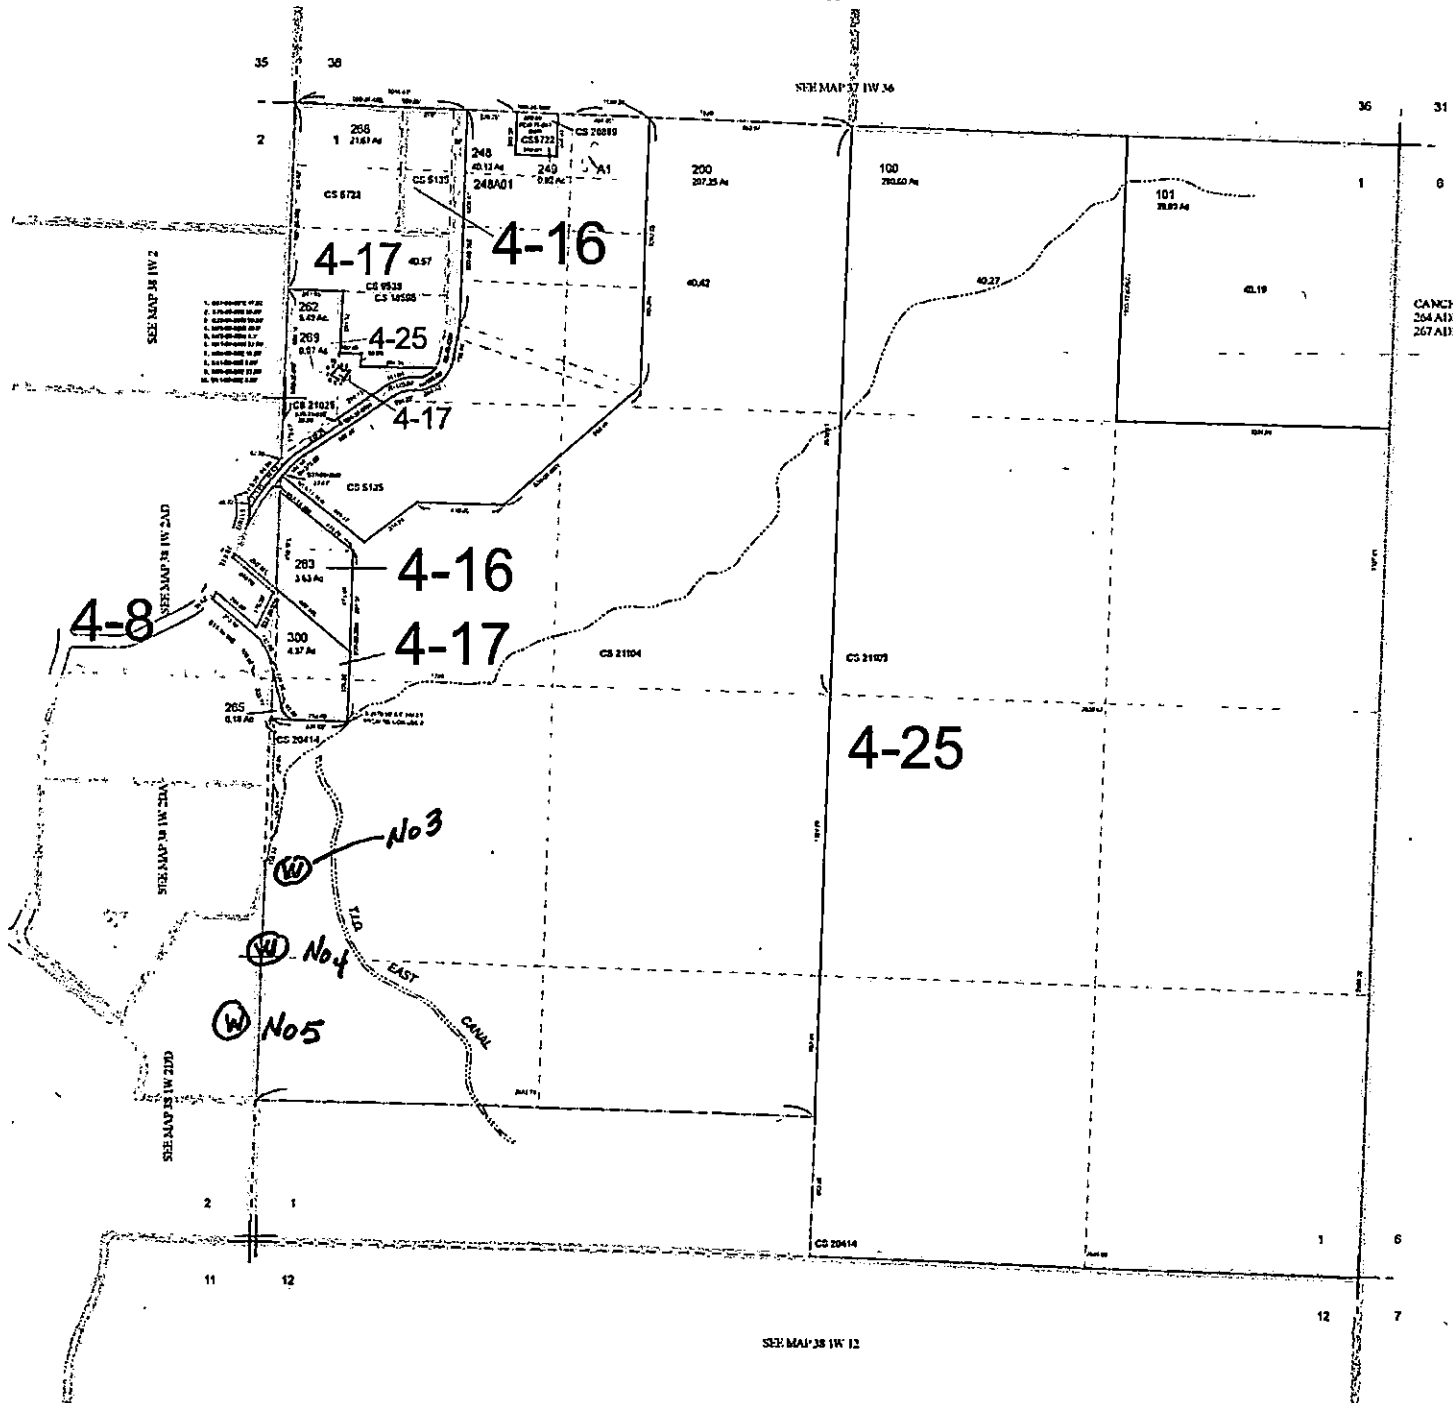

CANCELLED TAX LOT NUMBERS
264 ADDED TO 381W02A-263
267 ADDED TO 268

GIS DATA
02/25/2019 2:07:01 PM tk_brown@pb

SEE MAP 38 1W 12

381W1
NEW MAP February 10, 2017
REV June 21, 2018