



Oregon Water Resources Department
725 Summer Street NE, Suite A
Salem Oregon 97301
(503) 986-0900
www.oregon.gov/owrd

Application for
Well ID Number

RECEIVED

OCT 10 2019

OWRD

Do not complete if the well already has a Well Identification Number.

I. OWNER INFORMATION

Current Owner Name (please print): Fern Valley Estates Improvement District, (Well No. 3)

Mailing Address: 2387 Terri Drive

City, State, Zip: Medford, OR 97504

Mail Well ID to: [] SAME AS ABOVE [X] In Care Of (C/O)

Name & Address: Harold L. Center, President FVEID

City, State, Zip: 2604 David Lane, Medford, OR 97504

II. WELL LOCATION INFORMATION (Please fill out as completely as possible)

Township: 38 South (North / South) Range: 1 West (East / West) Section: 1 NW 1/4 of the SW 1/4

Tax Lot (usually last 3-5 numbers of Tax Map #): 200 County Jackson

GPS Coordinates: 42d 17' 31.75" N 122d 46' 37.08" W

Street Address of Well, City: 3081 Payne Road, Medford, Or 97504

If the property had a different street address in the past: P.O. Box 982, Phoenix OR on well log

III. GENERAL WELL INFORMATION (Please fill out as completely as possible, AND attach copy of Well Report, if available)

Use of Well (domestic, irrigation, commercial, industrial, monitoring): Domestic

Date Well Constructed (or property built): 10/14/1992 deepen Total Well Depth: 400' Casing Diameter: 6"

Owner at time the well was constructed (if known): FVEID Well Report # (if known): Jack 32046

Other Information: Referenced Jack Number is when the well was drilled from 200' to 400'

SUBMITTED BY (please print): Harold L. Center, President FVEID [Signature]

PHONE: 541-535-6108 EMAIL &/or FAX: center1071@gmail.com

Send application to: Oregon Water Resources Department 725 Summer St NE, Suite A, Salem, Oregon 97301; or fax to (503) 986-0902. Applications are processed in the order they are received, and Well ID Numbers are mailed within 4-5 business days.

For Official Use Only by the Oregon Water Resources Department:

Received Date: 10-10-19

Well Report Number: JACK 32046

Well Identification #: L-135926


1/4 SECTION 2, T. 38S, R. 1W, W.M.
JACKSON COUNTY

JACK 32046

E. 1/4 SEC. 2 T. 38S. R. 1W. W.M.
JACKSON COUNTY
1" = 100'

381W2DA

RECEIVED
OCT 10 2019
OWRD

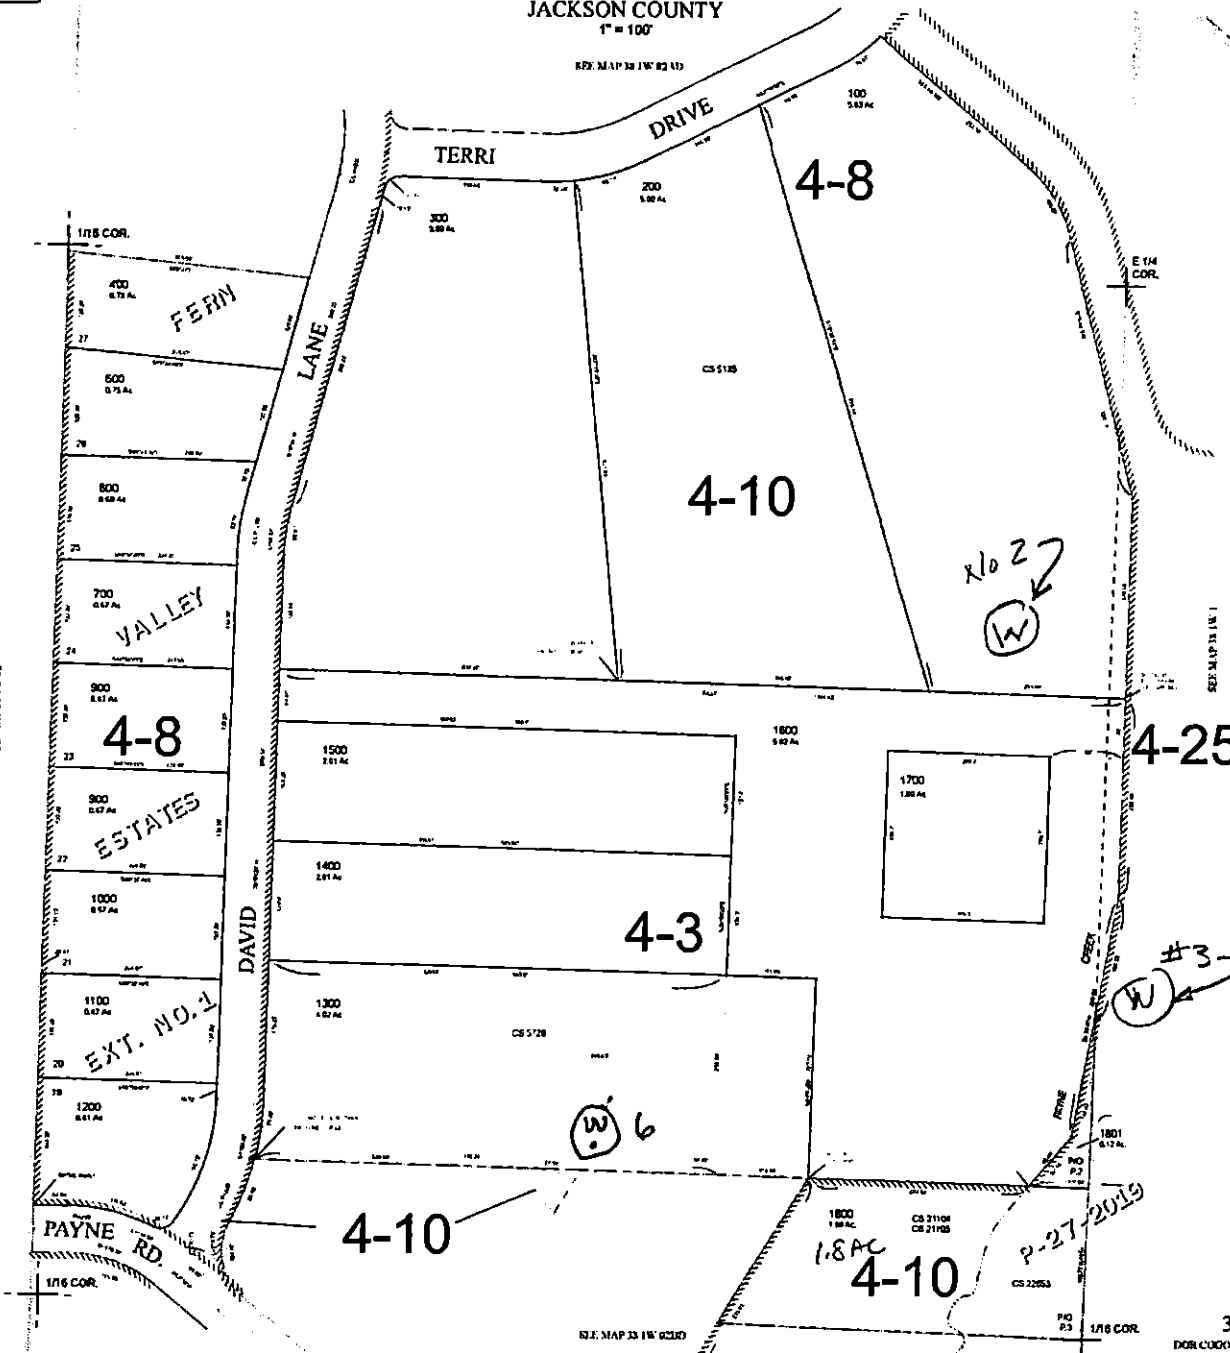

CS DATA
07/08/2018 8:41:30 AM

381W2DA
DOR CUDO February 21 2014
REV July 1, 2019