

RECEIVED

MAR 17 1994

WATER RESOURCES DEPT

APR 13 1994 # 61176

38S/1W/2E

(1) OWNER: SALEM, OREGON
Well Number _____
Name Fern Valley Water District
Address P.O. Box 982
City Phoenix State OR Zip 97535

(2) TYPE OF WORK:
 New Well Deepen Recondition Abandon

(3) DRILL METHOD:
 Rotary Air Rotary Mud Cable
 Other _____

(4) PROPOSED USE:
 Domestic Community Industrial Irrigation
 Thermal Injection Other _____

(5) BORE HOLE CONSTRUCTION:
Special Construction approval Yes No Depth of Completed Well 406 ft.
Explosives used Yes No Type _____ Amount _____

HOLE Diameter	From To		Material	SEAL From To		Amount sacks or pounds
6	112	406				
SEAL NOT DISTURBED						

How was seal placed: Method A B C D E
 Other _____

Backfill placed from _____ ft. to _____ ft. Material _____
Gravel placed from _____ ft. to _____ ft. Size of gravel _____

(6) CASING/LINER:

Diameter	From	To	Gauge	Steel	Plastic	Welded	Threaded
Casing:				<input type="checkbox"/>	<input type="checkbox"/>	<input type="checkbox"/>	<input type="checkbox"/>
Liner:	4	-2	406 1/4	<input type="checkbox"/>	<input checked="" type="checkbox"/>	<input type="checkbox"/>	<input type="checkbox"/>

Final location of shoe(s) _____

(7) PERFORATIONS/SCREENS:

Perforations Method SAW
 Screens Type _____ Material _____

From	To	Slot size	Number	Diameter	Tele/pipe size	Casing	Liner
60	160	7"	30	1/8	4"	<input type="checkbox"/>	<input checked="" type="checkbox"/>
306	406	7"	30	1/8	4"	<input type="checkbox"/>	<input checked="" type="checkbox"/>

(8) WELL TESTS: Minimum testing time is 1 hour

Pump Bailer Air Flowing Artesian

Yield gal/min	Drawdown	Drill stem at	Time
150+			1 hr.
100		405	2 1/4 hrs.

Temperature of Water 58 Depth Artesian Flow Found _____
Was a water analysis done? Yes By whom _____
Did any strata contain water not suitable for intended use? Too little
 Salty Muddy Odor Colored Other _____
Depth of strata: _____

(9) LOCATION OF WELL by legal description:
County Jackson Latitude _____ Longitude _____
Township 38S N or S. Range 1W E or W. WM.
Section 2D 1/4 1/4
Tax Lot 100 Lot _____ Block _____ Subdivision _____
Street Address of Well (or nearest address) 3081 Payne Rd.
Phoenix OR

(10) STATIC WATER LEVEL:
53 ft. below land surface. Date 3/12/94
Artesian pressure _____ lb. per square inch. Date _____

(11) WATER BEARING ZONES:
Depth at which water was first found 294

From	To	Estimated Flow Rate	SWL
294	317	40	
317	342	60	53

(12) WELL LOG:
Ground elevation _____

Material	From	To	SWL
Clean out cave in			
Sandstone Fractures	112	125	
Sandstone Blue	125	162	
Sandstone Soft White	162	163	
Sandstone Blue	163	181	
Sandstone Conglomerate			
Blue	181	187	
Sandstone Blue	187	294	
Cemented Gravel	294	317	
Claystone Fractured 3"			
Adobe	317	342	
Sandstone Blue	342	406	53

Date started 3/11/94 Completed 3/12/94

(unbonded) Water Well Constructor Certification:
I certify that the work I performed on the construction, alteration, or abandonment of this well is in compliance with Oregon well construction standards. Materials used and information reported above are true to my best knowledge and belief.
Signed _____ Date _____ WWC Number _____

(bonded) Water Well Constructor Certification:
I accept responsibility for the construction, alteration, or abandonment work performed on this well during the construction dates reported above. All work performed during this time is in compliance with Oregon well construction standards. This report is true to the best of my knowledge and belief.
Signed John Shudbek Date 3-15-94 WWC Number 679



Oregon Water Resources Department
725 Summer Street NE, Suite A
Salem Oregon 97301
(503) 986-0900
www.oregon.gov/owrd

Application for
Well ID Number

RECEIVED
OCT 10 2019
OWRD

Do not complete if the well already has a Well Identification Number.

I. OWNER INFORMATION

Current Owner Name (please print): Fern Valley Estates Improvement District, (Well No. 4)
Mailing Address: 2387 Terri Drive
City, State, Zip: Medford, OR 97504
Mail Well ID to: [] SAME AS ABOVE [X] In Care Of (C/O)
Name & Address: Harold L. Center, President FVEID
City, State, Zip: 2604 David Lane, Medford, OR 97504

II. WELL LOCATION INFORMATION (Please fill out as completely as possible)

Township: 38 South (North / South) Range: 1 West (East / West) Section: 1 NW 1/4 of the SW 1/4
Tax Lot (usually last 3-5 numbers of Tax Map #): 200 County Jackson
GPS Coordinates: 42d 17' 28.88" N 122d 46' 37.67" W
Street Address of Well, City: 3081 Payne Road, Medford, Or 97504
If the property had a different street address in the past: P.O. Box 982, Phoenix OR on well log Jack 33100

III. GENERAL WELL INFORMATION (Please fill out as completely as possible, AND attach copy of Well Report, if available)

Use of Well (domestic, irrigation, commercial, industrial, monitoring): Domestic
Date Well Constructed (or property built): 03/11/1994 deepen Total Well Depth: 406' Casing Diameter: 6" JACK
Owner at time the well was constructed (if known): FVEID Well Report # (if known): Jack 14480/33100
Other Information: Referenced Jack Number is when the well was drilled from 112' to 406'

SUBMITTED BY (please print): Harold L. Center, President FVEID [Signature]
PHONE: 541-535-6108 EMAIL &/or FAX: center1071@gmail.com

Send application to: Oregon Water Resources Department 725 Summer St NE, Suite A, Salem, Oregon 97301; or fax to (503) 986-0902.
Applications are processed in the order they are received, and Well ID Numbers are mailed within 4-5 business days.

For Official Use Only by the Oregon Water Resources Department:

Received Date: 10-10-19 Well Report Number: JACK 14480 + JACK 33100 Well Identification #: L-135927
- ORIG - - DEEPEMED -

JACK 33100


SECTION 1 T.38S. R.1W. W.M.
JACKSON COUNTY

381W1

FOR ASSESSMENT AND
TAXATION ONLY

1" = 400'

RECEIVED
OCT 10 2019
OWRD

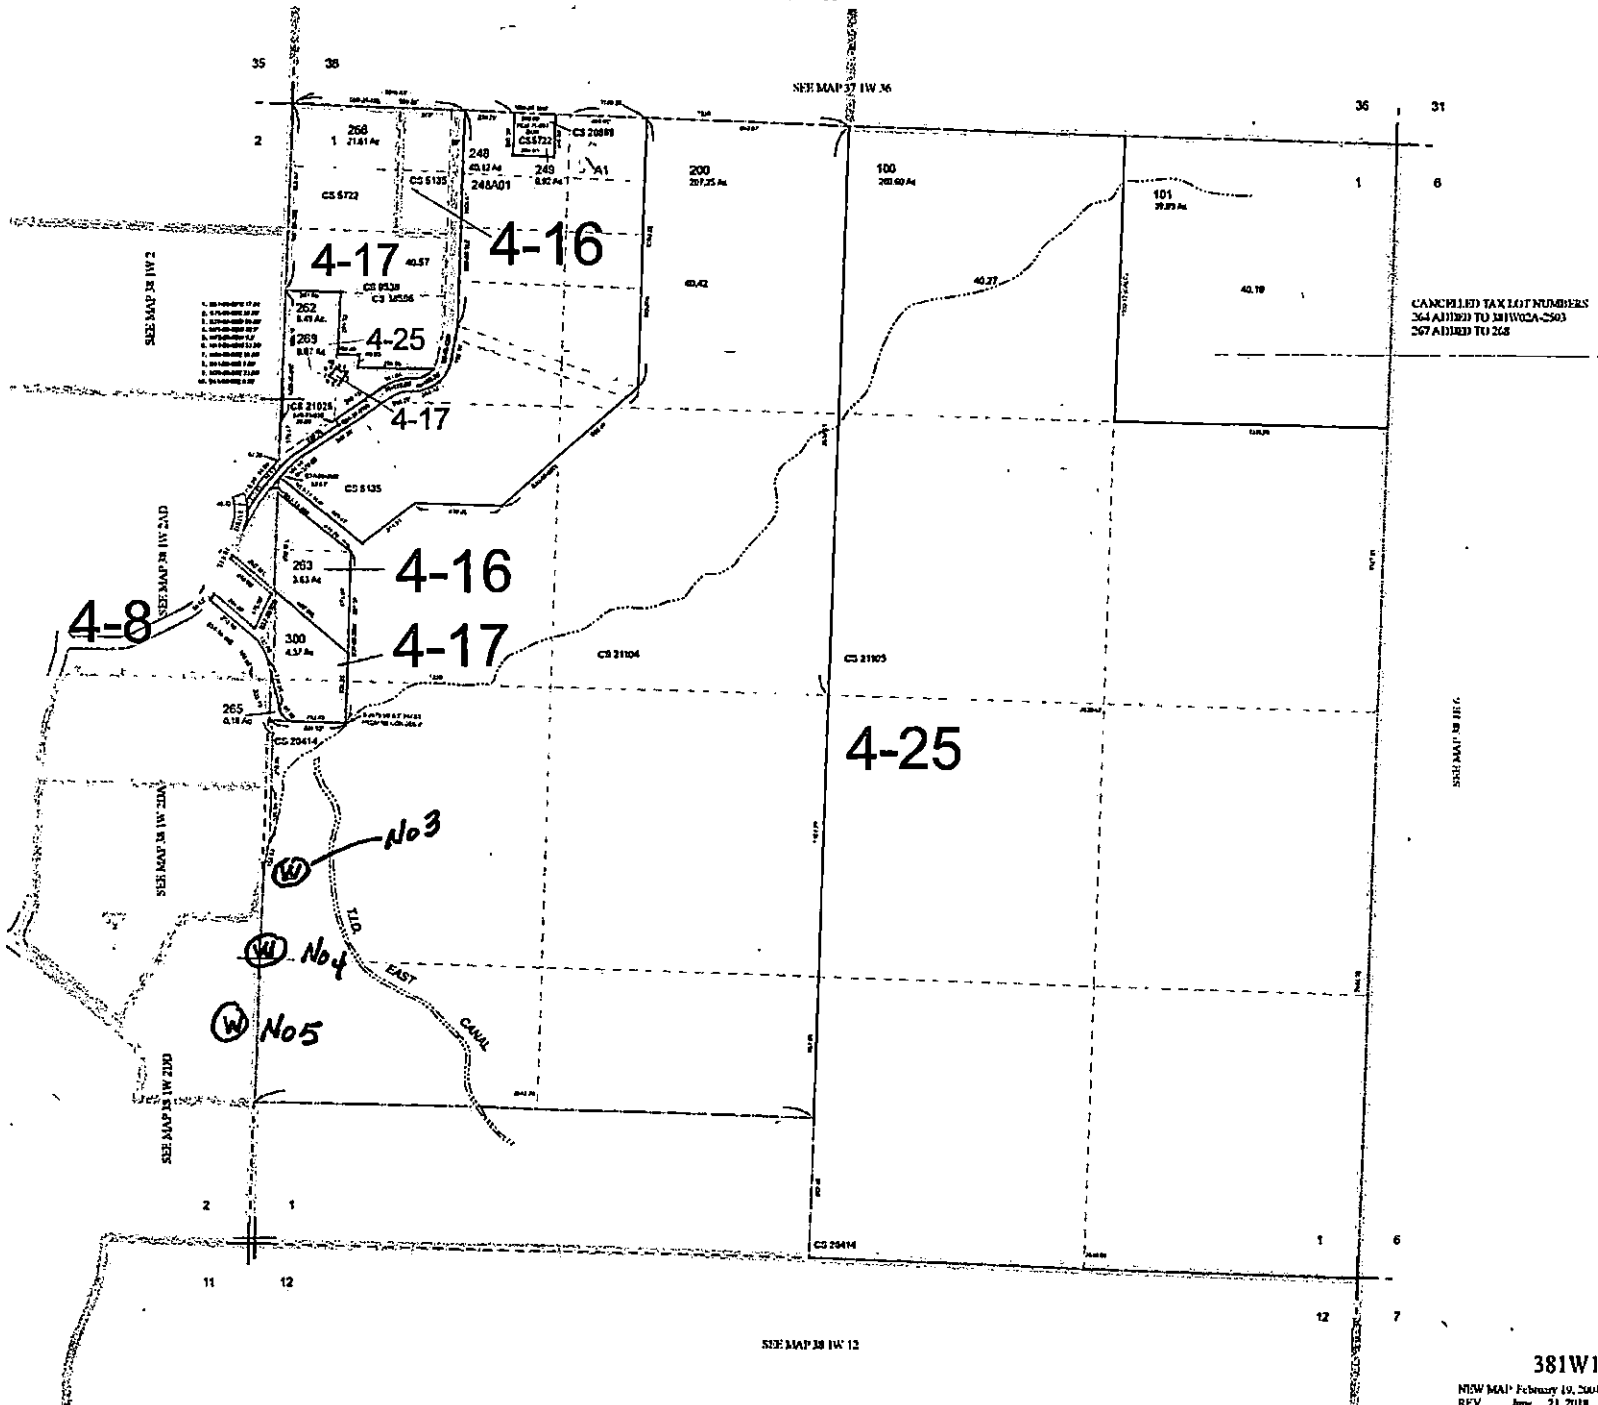

C/S DATA
06/25/2018 2:07:01 PM bcaun@pb

JACK 33100

STATE OF OREGON WELL LOCATION MAP

This map is supplemental to the WATER SUPPLY WELL REPORT

Oregon Water Resources Department

725 Summer St NE, Salem OR 97301
(503)986-0900



LOCATION OF WELL

Latitude: 42.29135556 Datum: WGS84

Longitude: -122.77713056

Township/Range/Section/Quarter-Quarter Section:

WM 38S 1W 2 NESE

Address of Well:

3081 PAYNE RD

Well Label: L135927

Well Log: JACK 33100

Printed: October 16, 2019

DISCLAIMER: This map is intended to represent the approximate location of the well as provided by the land owner, well driller or OWRD staff. It is not intended to be construed as survey accurate in any manner.

Generated by OWRD

