

STATE OF OREGON  
WATER WELL REPORT  
(as required by ORS 537.765)

MARI  
18670

SEP 27 1993

WATER RESOURCES DEPT  
SALEM OREGON

33/1w/33da  
(START CARD) # w 36780

(1) OWNER: Well Number: \_\_\_\_\_  
Name James & Mary Loennig  
Address 23875 Klumpner Rd.  
City Flora State Ore Zip 97002

(2) TYPE OF WORK:  
 New Well  Deepen  Recondition  Abandon

(3) DRILL METHOD  
 Rotary Air  Rotary Mud  Cable  
 Other \_\_\_\_\_

(4) PROPOSED USE:  
 Domestic  Community  Industrial  Irrigation  
 Thermal  Injection  Other \_\_\_\_\_

(5) BORE HOLE CONSTRUCTION:  
Special Construction approval Yes No Depth of Completed Well 238 ft.  
Explosives used  Yes  No  Type \_\_\_\_\_ Amount \_\_\_\_\_

HOLE			SEAL			Amount sacks or pounds
Diameter	From	To	Material	From	To	
12	0	20	Cement	0	20	44 sacks
8	20	238				

How was seal placed: Method  A  B  C  D  E  
 Other Tremie  
Backfill placed from \_\_\_\_\_ ft. to \_\_\_\_\_ ft. Material \_\_\_\_\_  
Gravel placed from \_\_\_\_\_ ft. to \_\_\_\_\_ ft. Size of gravel \_\_\_\_\_

(6) CASING/LINER:

Diameter	From	To	Gauge	Steel	Plastic	Welded	Threaded
8	71	238	250	<input checked="" type="checkbox"/>	<input type="checkbox"/>	<input checked="" type="checkbox"/>	<input type="checkbox"/>
				<input type="checkbox"/>	<input type="checkbox"/>	<input type="checkbox"/>	<input type="checkbox"/>
				<input type="checkbox"/>	<input type="checkbox"/>	<input type="checkbox"/>	<input type="checkbox"/>
				<input type="checkbox"/>	<input type="checkbox"/>	<input type="checkbox"/>	<input type="checkbox"/>
				<input type="checkbox"/>	<input type="checkbox"/>	<input type="checkbox"/>	<input type="checkbox"/>

Liner: \_\_\_\_\_

Final location of sheets: \_\_\_\_\_

(7) PERFORATIONS/SCREENS:  
 Perforations Method Star Drive Down  
 Screens Type \_\_\_\_\_ Material \_\_\_\_\_

From	To	Slot size	Number	Diameter	Tele/pipe size	Casing	Liner
215	238	1/2 x 3/8	420	8		<input checked="" type="checkbox"/>	<input type="checkbox"/>
						<input type="checkbox"/>	<input type="checkbox"/>
						<input type="checkbox"/>	<input type="checkbox"/>
						<input type="checkbox"/>	<input type="checkbox"/>
						<input type="checkbox"/>	<input type="checkbox"/>

(8) WELL TESTS: Minimum testing time is 1 hour  
 Pump  Bailer  Air  Flowing Artesian  
Yield gal/min 350 Drawdown \_\_\_\_\_ Drill stem at 230 Time 6 hr.

Temperature of water 53° Depth Artesian Flow Found \_\_\_\_\_  
Was a water analysis done?  Yes By whom \_\_\_\_\_  
Did any strata contain water not suitable for intended use?  Too little  
 Salty  Muddy  Odor  Colored  Other Too fine  
Depth of strata: 3 ft.

(9) LOCATION OF WELL by legal description:  
County Marion Latitude \_\_\_\_\_ Longitude \_\_\_\_\_  
Township 35 Nor or S. Range 1 W E or W. WM.  
Section 33 NE 1/4 SE 1/4  
Tax Lot \_\_\_\_\_ Lot \_\_\_\_\_ Block \_\_\_\_\_ Subdivision \_\_\_\_\_  
Street Address of Well (or nearest address) \_\_\_\_\_

(10) STATIC WATER LEVEL:  
80 ft. below land surface. Date 9-24-93  
Artesian pressure \_\_\_\_\_ lb. per square inch. Date \_\_\_\_\_

(11) WATER BEARING ZONES:  
Depth at which water was first found 101

From	To	Estimated Flow Rate	SWL
196	234	500+	80

(12) WELL LOG: Ground elevation \_\_\_\_\_

Material	From	To	SWL
Top of Brown clay	0	71	
Blue sticky clay	71	87	
Dark clay (sticky)	87	101	
Fine Dark sand	101	104	60
Brown sandy clay	104	111	
Dark sand & clay	111	127	
Blue clay (sticky)	127	133	
Dark gray clay	133	157	
Dark silty clay	157	172	
Dark sand	172	187	80
Sand some gravel	187	192	80
Dark Hard pan	192	196	
Fine sand & gravel	196	234	80
Gray clay	234	238	

Date started Sept 1 93 Completed Sept 24 93

(unbonded) Water Well Constructor Certification:  
I certify that the work I performed on the construction, alteration, or abandonment of this well is in compliance with Oregon well construction standards. Materials used and information reported above are true to my best knowledge and belief.  
Signed \_\_\_\_\_ WWC Number \_\_\_\_\_ Date \_\_\_\_\_

(bonded) Water Well Constructor Certification:  
I accept responsibility for the construction, alteration, or abandonment work performed on this well during the construction dates reported above. All work performed during this time is in compliance with Oregon well construction standards. This report is true to the best of my knowledge and belief.  
Signed John W Beck WWC Number 449 Date 9-24-93

FOR WATER RESOURCES DEPARTMENT USE ONLY

Date Postmarked \_\_\_\_\_  
 Date Hand-delivered \_\_\_\_\_  
 Watermaster Initials \_\_\_\_\_

W- 36780  
 WRD Receipt 103897  
 Date Fee Received 8-23-93

CHECK NO. \_\_\_\_\_

**START CARD**  
**NOTICE OF BEGINNING OF WELL CONSTRUCTION**  
 (as required by ORS 537.762)

This form must be completed, signed by both the owner (or authorized agent) and constructor, and the original mailed or delivered to the Water Resources Department, 3850 Portland Road NE, Salem, OR 97310, no later than the day construction, alteration, conversion or abandonment work begins. A \$75 fee shall accompany all notices for new well construction or conversion of an existing hole not previously used as a water well (make checks payable to the Water Resources Department). Notices meeting this requirement but received without the required fee will not be accepted as properly and timely filed. The Water Resources Commission has authority to impose civil penalties for failure to submit the required \$75 fee with the start card and for failure to submit cards prior to beginning any construction, alteration, conversion or abandonment work.

Owner's name and mailing address James & Mary Loennig  
23875 Klupenger Rd  
Aurora Ore 97002

**RECEIVED**  
 AUG 30 1993


Check type of work: Fee Required  New construction  Conversion  
 No Fee Required  Repair  Deepening  
 Recordation  Abandonment

Proposed Commencement Date 8-31-93 Existing or Proposed Well Depth 250 Diameter 8"

Check Use:  Domestic  Community  Industrial  Irrigation  Monitoring  
 Thermal  Injection  Other \_\_\_\_\_

Proposed Well Location: County Marion Owner's Well Id. No. \_\_\_\_\_  
 Township 33 (N or S) Range 1W (E or W) Section 33

- NE 1/4 of SE 1/4 of above section
- Street address of well location 23875 Klupenger Rd.  
Aurora Ore
- Tax lot number of well location 1100
- Attach map with location identified.  
 (See reverse of this form for approved maps)
- Show well location within 1/4, 1/4 of section grid at left.

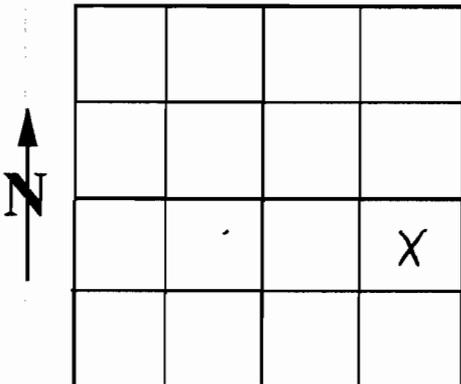


We hereby certify that we have read the back of this form, and that to the best of our knowledge the information provided herein is accurate and the well is being properly located from septic tanks, septic drain fields and other hazards. (See #2 on back)

James A. Loennig Mary Loennig  
 Owner's signature  
owner Title 8-27-93 Date  
678-1221 Home phone 225-8472 Work phone


John W. Becke  
 Bonded Water Well Constructor  
 License No. 449  
 Company Beck Well Drilling

NOTE: This is not a water right application. The owner is responsible for obtaining a water right through the Water Resources Department, if required.

THIS COPY TO WATER RESOURCES DEPARTMENT IN SALEM  
 If no fee applies, discard this copy

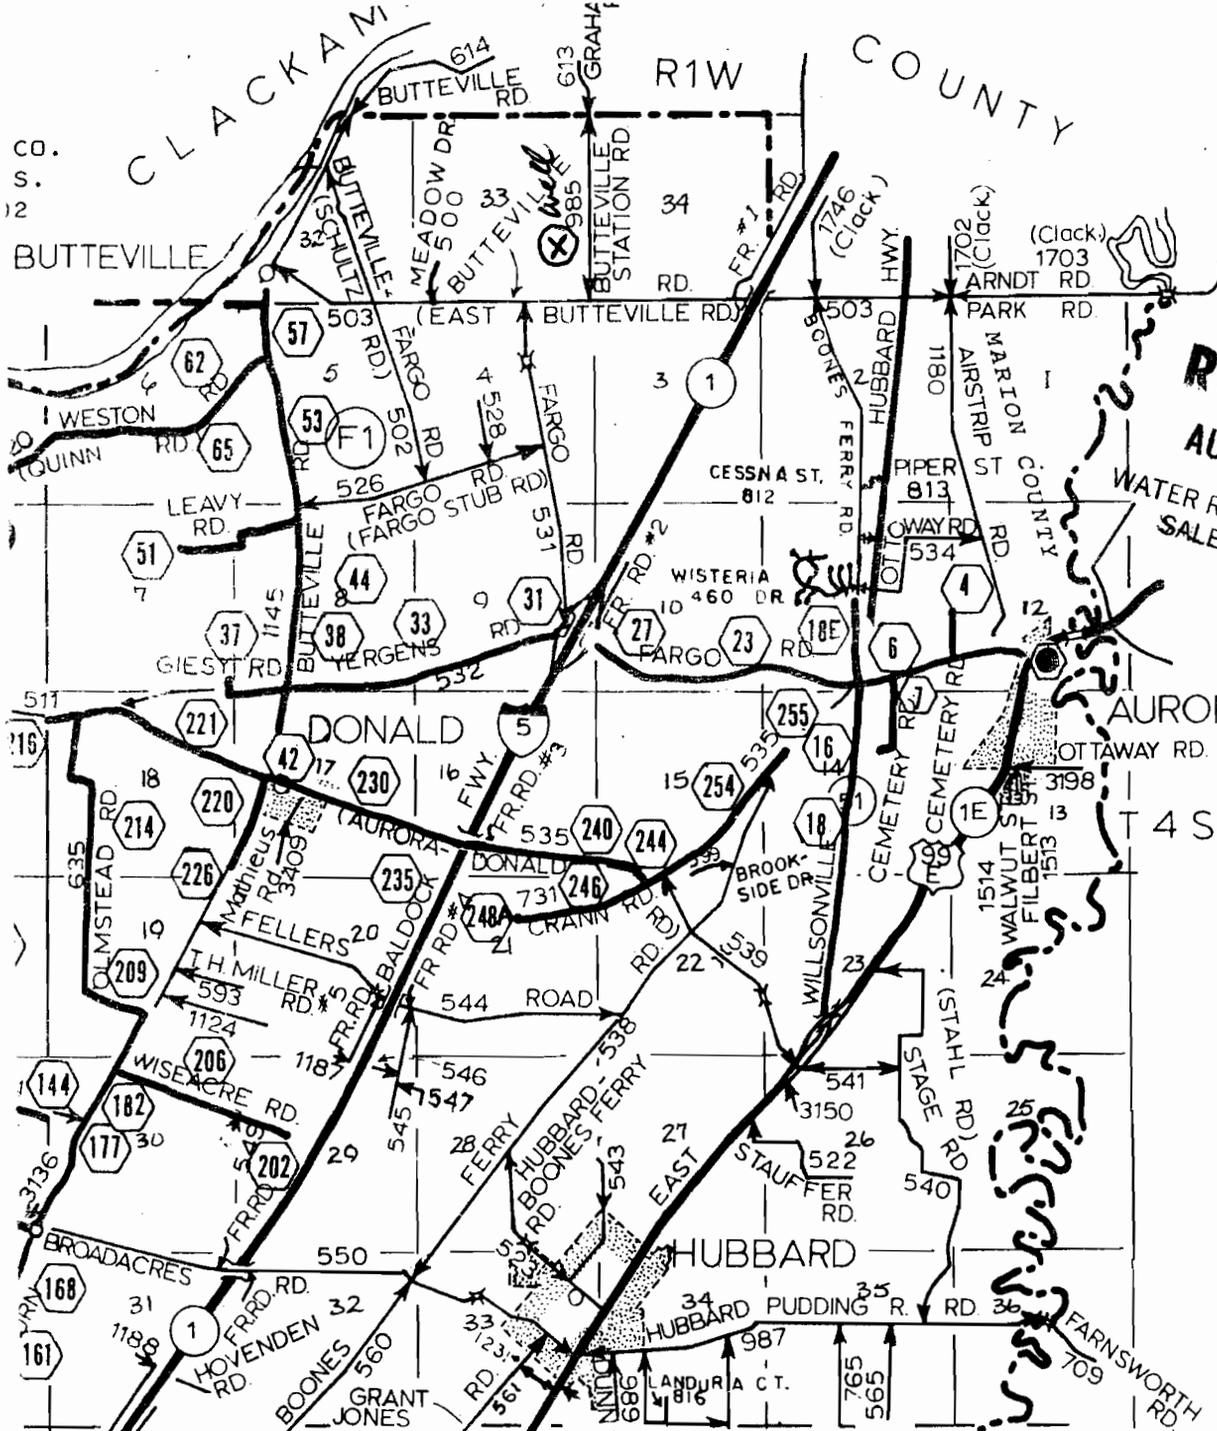

**RECEIVED**  
**AUG 30 1993**  
 WATER RESOURCES DEPT  
 SALEM, OREGON

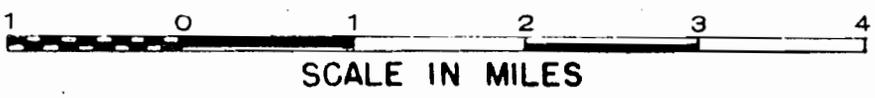



Oregon Water Resources Department  
 725 Summer Street NE, Suite A  
 Salem Oregon 97301  
 (503) 986-0900  
 www.oregon.gov/owrd

# Application for Well ID Number

RECEIVED

**Do not complete if the well already has a Well Identification Number.**

JAN 22 2026

OWRD

**I. OWNER INFORMATION**

Current Owner Name (please print): Katherine and Joshua McBee

Mailing Address: 23875 Klupenger Rd NE

City, State, Zip: Aurora, OR 97002

Mail Well ID to:  SAME AS ABOVE  In Care Of (C/O)

Name & Address: \_\_\_\_\_

City, State, Zip: \_\_\_\_\_

**II. WELL LOCATION INFORMATION** (Please fill out as completely as possible)

Township: 3 S (North / South) Range: 1 W (East / West) Section: 33 NE 1/4 of the SE 1/4

Tax Lot (usually last 3-5 numbers of Tax Map #): 900 (was 1100) County Marion

GPS Coordinates: 45.26496739, -122.80640028

Street Address of Well, City: 23875 Klupenger Rd NE

If the property had a different street address in the past: \_\_\_\_\_

**III. GENERAL WELL INFORMATION** (Please fill out as completely as possible, AND attach copy of Well Report, if available)

Use of Well (domestic, irrigation, commercial, industrial, monitoring): Domestic

Date Well Constructed (or property built): 9-24-1993 Total Well Depth: 238' Casing Diameter: 8"

Owner at time the well was constructed (if known): Loennig Well Report # (if known): MARI 18670

Other Information: \_\_\_\_\_

SUBMITTED BY (please print): Joshua McBee

PHONE: 5037035359 EMAIL &/or FAX: josh@beathanfarms.com

To send the completed application, you may MAIL it to: Oregon Water Resources Dept. 725 Summer St NE, Suite A, Salem, Oregon 97301.  
 Or EMAIL the completed PDF form to: Ladeena.K.Ashley@water.oregon.gov, or FAX it to: (503) 986-0902.

For Official Use Only by the Oregon Water Resources Department:

Received Date:

1-22-2026

Well Report Number:

MARI 18670

Well Identification #:

L-160012