


Steve Coleman - Gary Baker
 Cable Tool Drilled Well
 as built to date -
 July 26, 1982

5s/3w-1/a/b
 Marion

by:
 SCHNEIDER EQUIPMENT, INC.
 21881 RIVER RD. N.E.
 ST. PAUL, OR 97137
 PH. (503) 633-2666

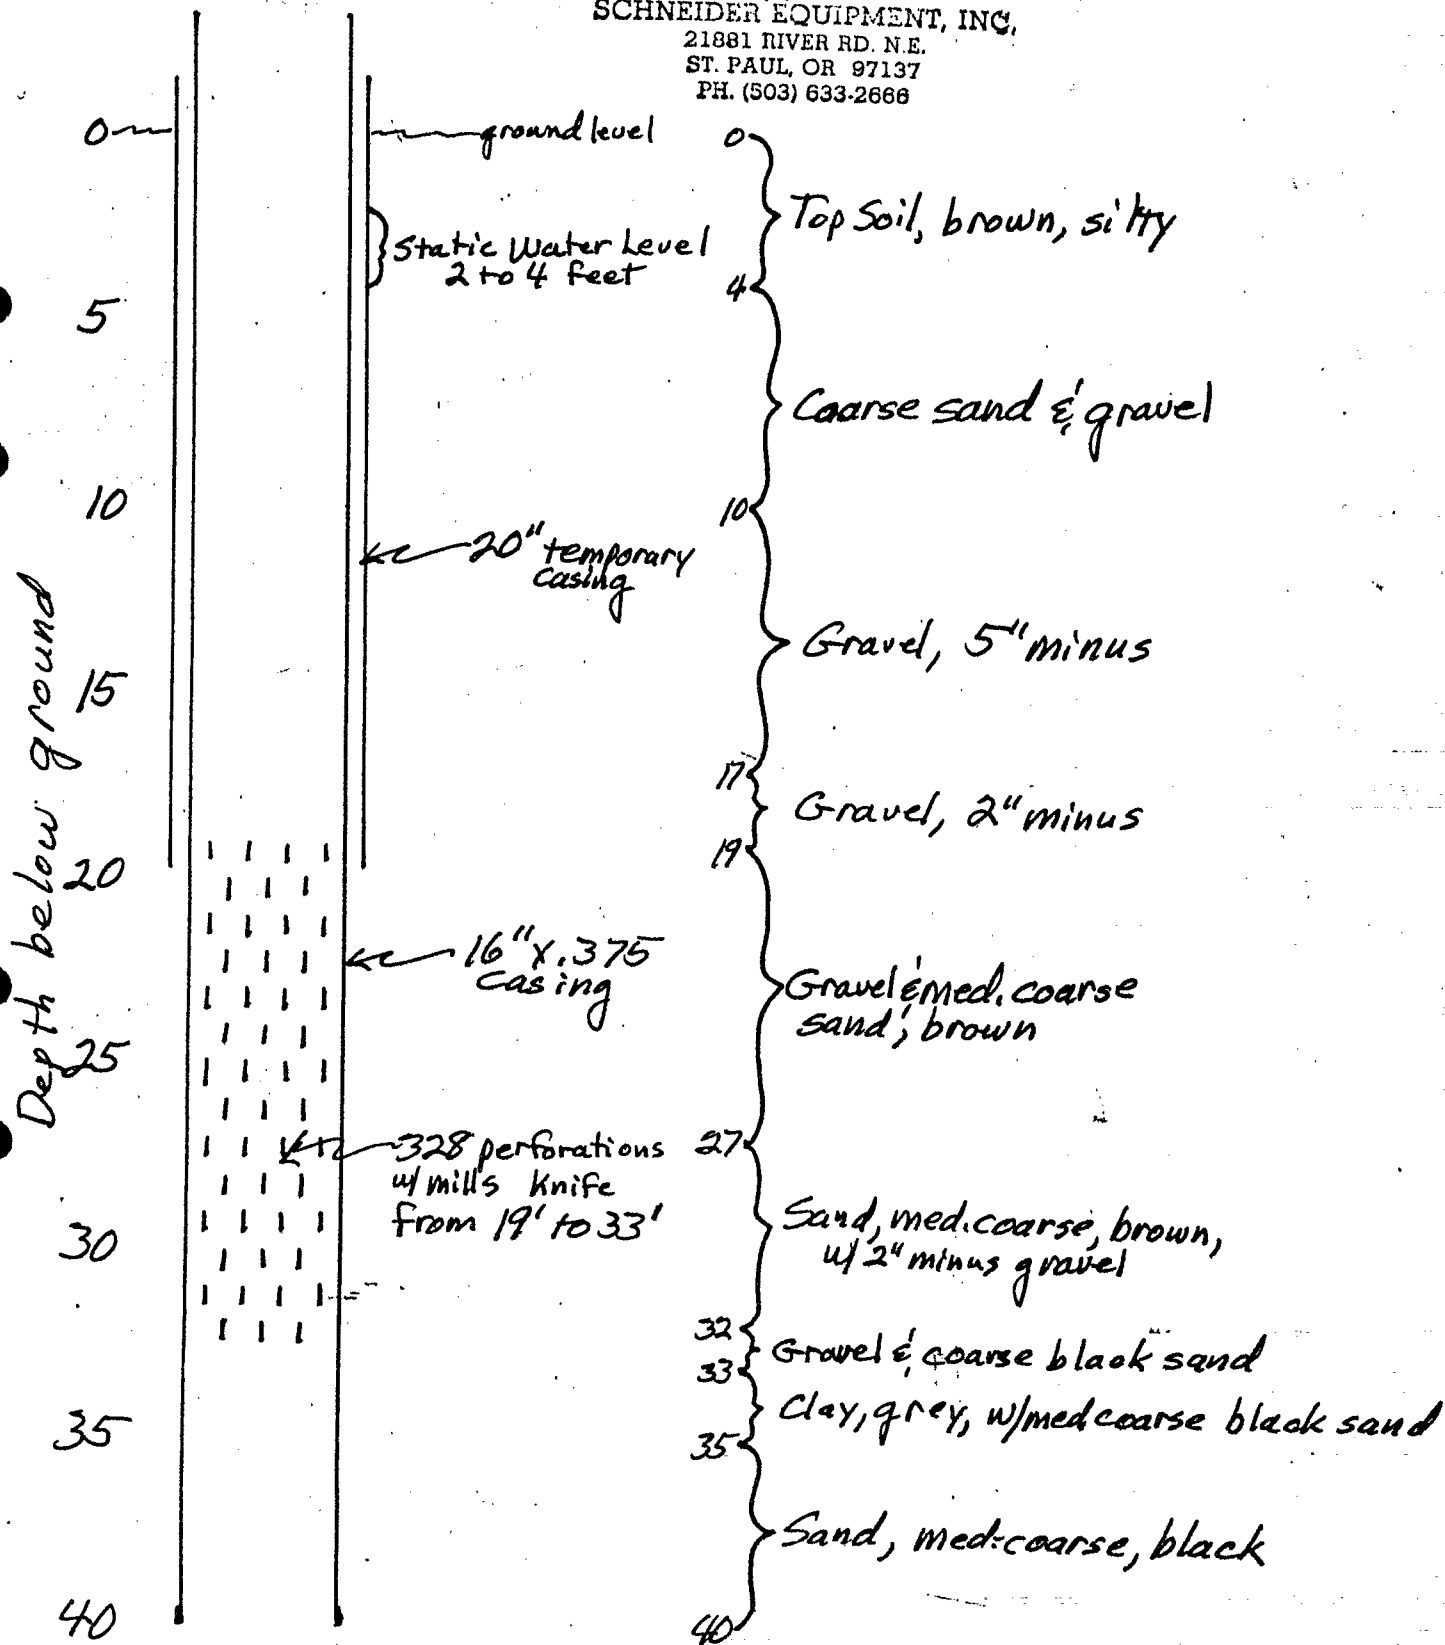

MARI 2890
 Steve Coleman - Gary Baker
 Cable Tool Drilled Well
 as proposed to be
 Completed July 26, 1982

55/3W-1/ab
 Marion
 by:

SCHNEIDER EQUIPMENT, INC.
 21881 RIVER RD. N.E.
 ST. PAUL, OR 97137
 PH. (503) 633-2666

