



Oregon Water Resources Department  
725 Summer Street NE, Suite A  
Salem Oregon 97301  
(503) 986-0900  
www.wrd.state.or.us

# Application for Well ID Number

H-1/F8

Do not complete if the well already has a Well I.D Number.

### I. OWNER INFORMATION

Current Owner Name (please print): USACOE Bonneville Lock & Dam  
Mailing Address: 184 EAST Exit 40  
City: Cascade Locks State: OR Zip: 97014  
Mailing Address (to send Well I.D.): P.O. Box 150  
City: Cascade Locks State: OR Zip: 97014

### II. WELL INFORMATION (Do not complete this section if the well report is attached.)

Township: 2 N (North/South) Range: 7 E (East/West) Section: 21  
Tax Lot: 6 Lot 2 County: Multnomah NE 1/4 SW 1/4  
Street Address of Well: 184E Exit 40 Robins Island City: Cascade Locks  
Owner at time the well was constructed, (if known): USACOE  
If the property had a different street address in the past:

### III. GENERAL WELL INFORMATION (Do not complete this section if the well report is attached)

Use of Well (domestic, irrigation, commercial, industrial, monitoring): Domestic + Industrial  
Date Well Constructed: 1987-1990 JVA Total Well Depth: 250.17 Casing Diameter: 20"  
Other Information: 227.22

SUBMITTED BY (please print): Dolores Pinault  
PHONE: 541-374-4014 FAX:

Send application to Oregon Water Resources Department; 725 Summer St NE, Suite A; Salem, Oregon 97301-1266; fax (503) 986-0902. Applications are processed and Well I.D. Numbers are mailed every Wednesday.

For Official Use Only by the Oregon Water Resources Department:		
Received Date:	Well Log Number:	Well Identification #:

Rec'd 6-4-13

Well Log # **MULT 113292**

**RECEIVED**

Well ID #


Last Update: 11/04/08

Well I.D. Number/1

wcc L-111885

JUN 04 2013


WATER RESOURCES DEPT  
SALEM, OREGON

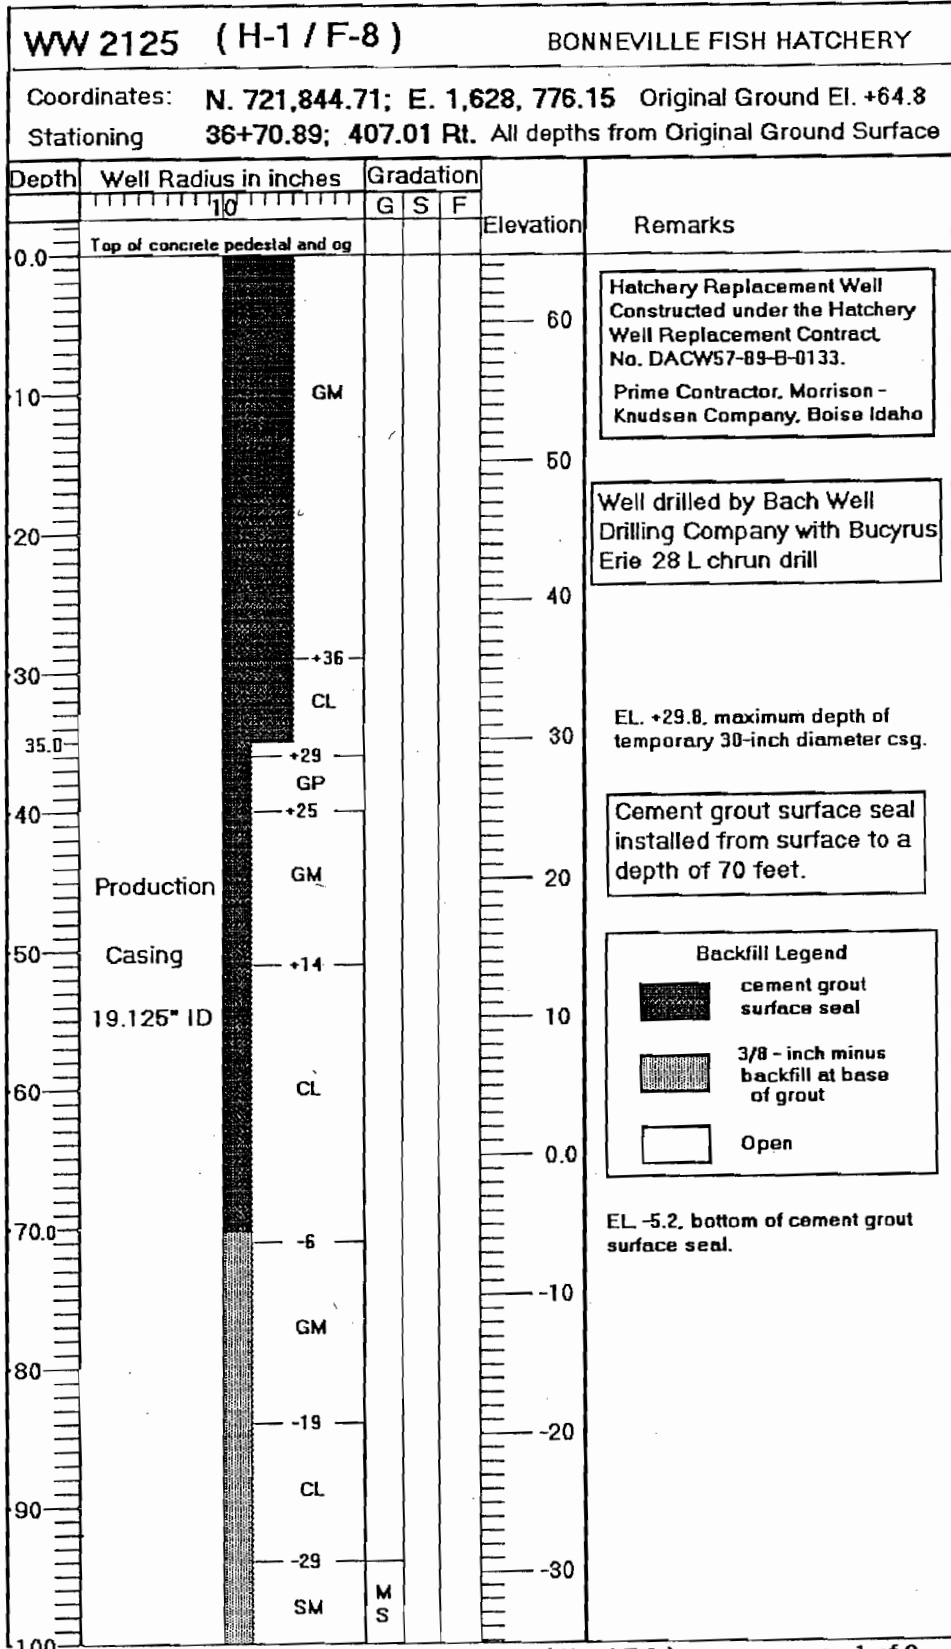

RECEIVED BY OWRD


JUN 14 2013

SALEM, OR

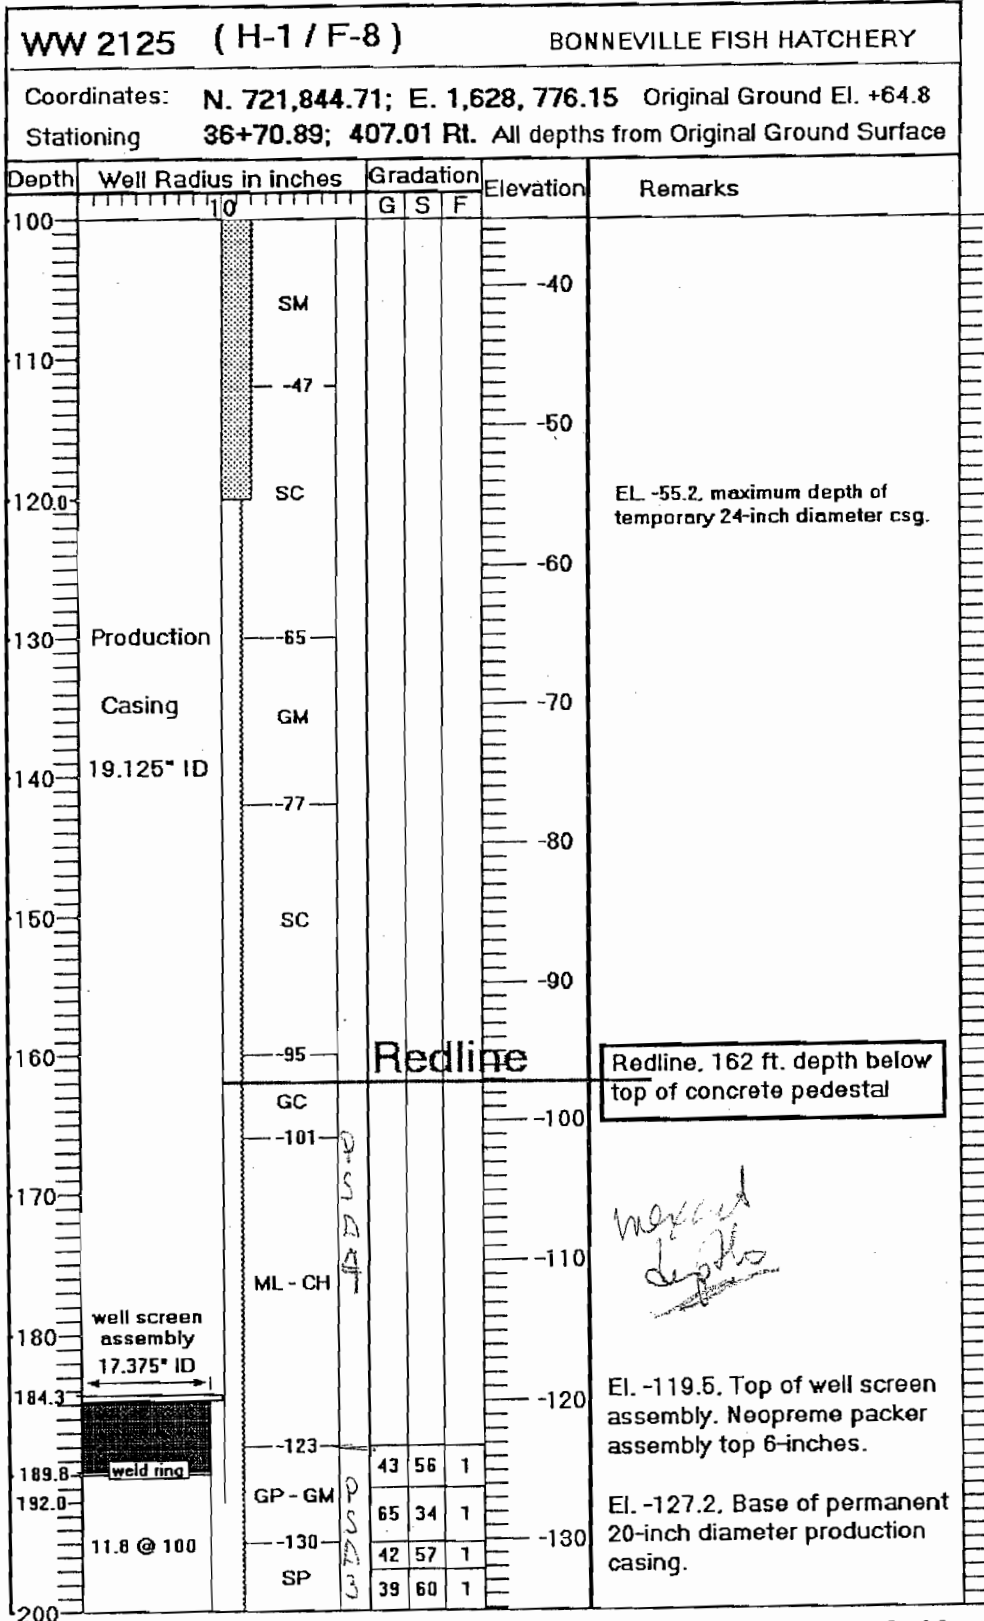

*Handwritten notes:*  
 1300' pipe used  
 around perimeter  
 of well  
 11.8 @ 100

*Handwritten note:*  
 Maxed depths

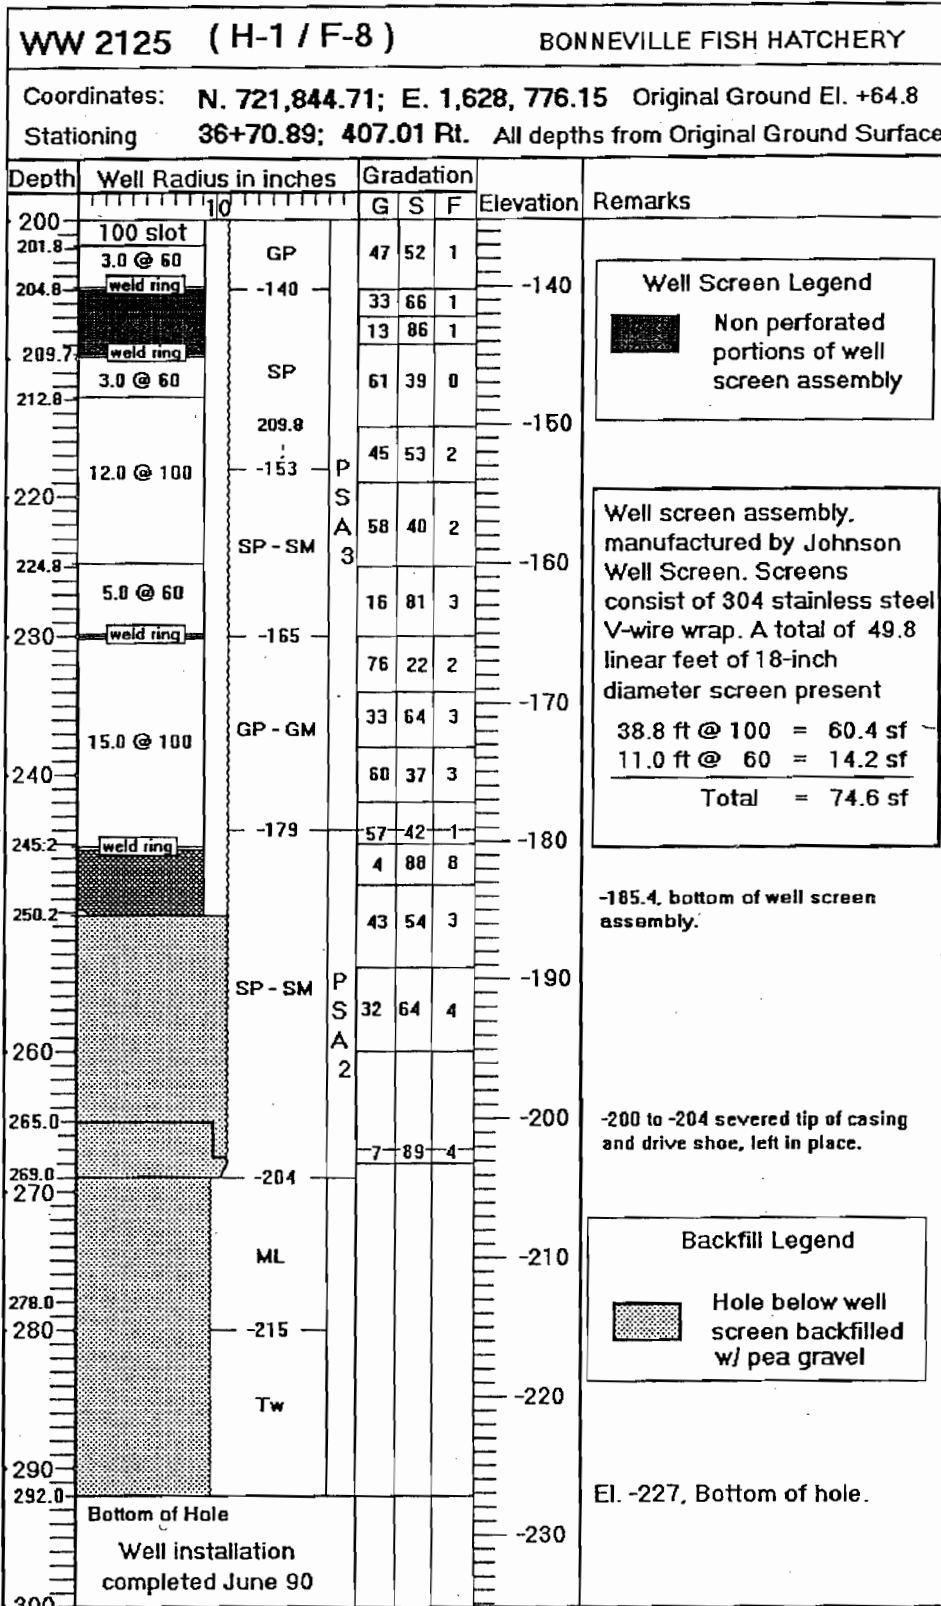

719  
144  

---

863

24

RECEIVED BY OWRD

JUN 14 2013

SALEM, OR



COMPANY

MULT 113292

JOB TITLE BONN NEW NAVIGATION - 4 SH WELLS

CONTRACT NO. 3302

DESCRIPTION AS-BUILT FOR CONSTRUCTION OF HATCHERY REPLACEMENT WELL F-8 (LUW-2125)


(DACW57-89-C-0117)

SHEET NO. 01

MADE BY DALE E CONOVER

CHECKED BY

DATE 5/31/90

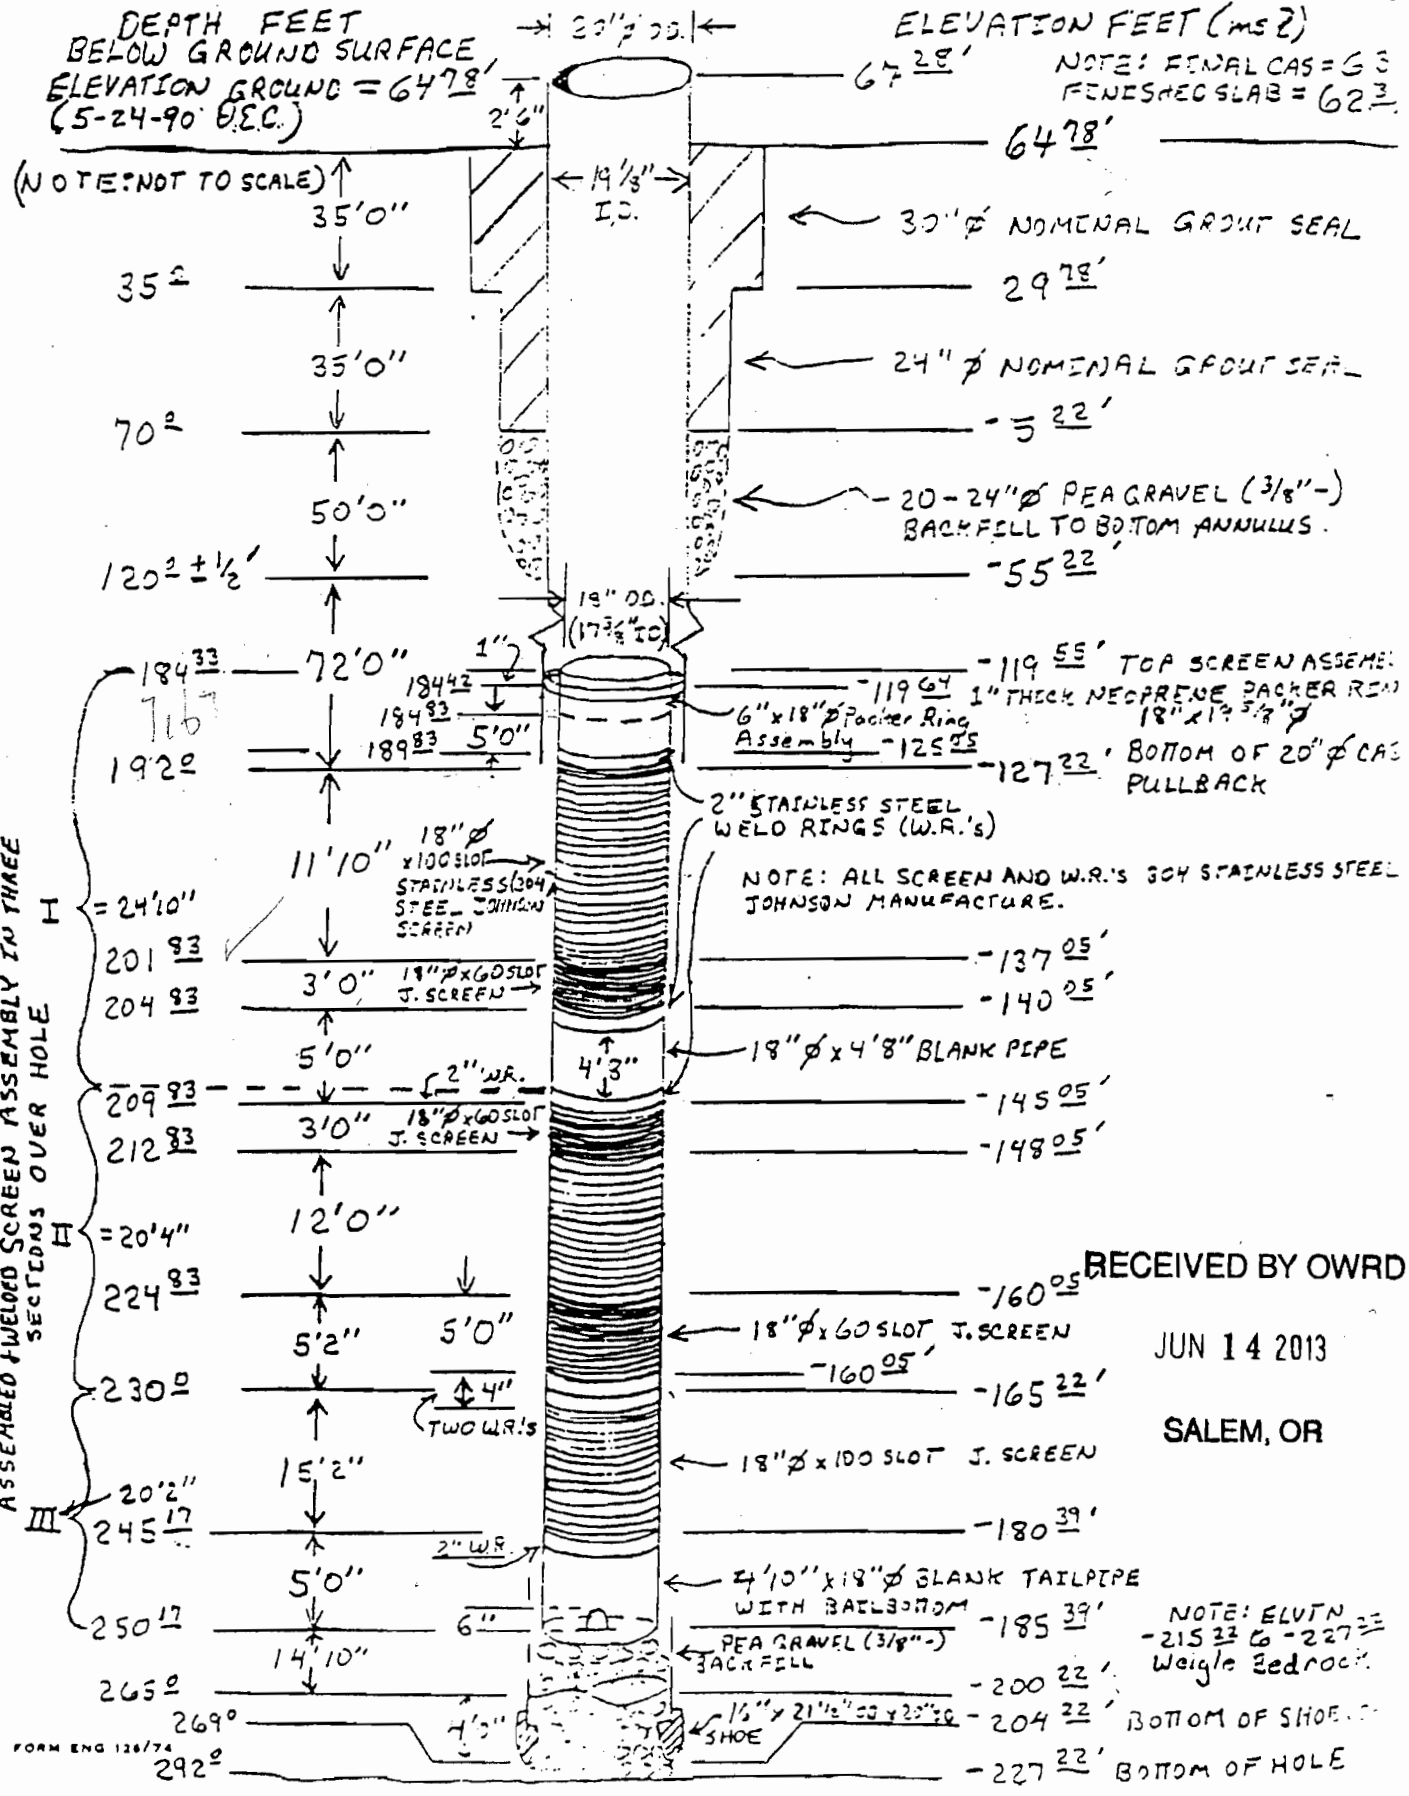

(NOTE: NOT TO SCALE)

ASSEMBLED WELDED SCREEN ASSEMBLY IN THREE SECTIONS OVER HOLE

RECEIVED BY OWRD

JUN 14 2013

SALEM, OR