





Oregon Water Resources Department  
 725 Summer Street NE, Suite A  
 Salem Oregon 97301  
 (503) 986-0900  
 www.wrd.state.or.us

# Application for Well ID Number

*Do not complete if the well already has a Well Identification Number.*

**I. OWNER INFORMATION**

Current Owner Name (please print): The Dalles Country Club  
 Mailing Address: ~~4550 Highway 30 West~~ P.O. Box 1624 **RECEIVED BY OWRD**  
 City, State, Zip: The Dalles OR 97058 **MAY 02 2017**  
 Mail Well ID Tag to:  SAME AS ABOVE  In Care Of (C/O)  
 Name & Address: \_\_\_\_\_ **SALEM, OR**  
 City, State, Zip: \_\_\_\_\_

**II. WELL LOCATION INFORMATION** (Please fill out as completely as possible)

Township: 2 (North /South) Range: 13 (East /West) Section: 17 NE 1/4 of the SE 1/4  
 Tax Lot (usually last 3-5 numbers of Tax Map #): 2N-13E-17D-100 County Wasco  
 GPS Coordinates: 1510' N & 320' W from SE Cor Sec 17 "Well #2"  
 Street Address of Well, City: 4550 Highway 30 West, The Dalles OR 97058  
 If the property had a different street address in the past: \_\_\_\_\_

**III. GENERAL WELL INFORMATION** (Please fill out as completely as possible, AND attach copy of Well Log, if available)

Use of Well (domestic, irrigation, commercial, industrial, monitoring): Irrigation  
 Date Well Constructed (or property built): 1972 Total Well Depth: 480' Casing Diameter: 12"  
 Owner at time the well was constructed (if known): TD Country Club Well Log # (if known): WASC 3230  
 Other Information: See also WASC 3224

SUBMITTED BY (please print): Jason Miller  
 PHONE: 541-993-4649 EMAIL &/or FAX: jason\_fdcc@gmail.com

Send application to: Oregon Water Resources Department 725 Summer St NE, Suite A, Salem, Oregon 97301; or fax to (503) 986-0902.  
 Applications are processed in the order they are received, and Well ID Numbers are mailed within 4-5 business days.

<i>For Official Use Only by the Oregon Water Resources Department:</i>		
Received Date: <u>5-2-17</u>	Well Log Numbers: <u>WASC 3230 (original)</u> <u>WASC 3224 (recondition)</u>	Well Identification #: <u>L-126121</u>



SECTION 17, TWP.2 N. RANGE 13 E. W.M.

WASCO COUNTY, OREGON

L E G E N D :

- L-14020 ● WELL #1 (WASC 3231): 820' N. & 1130' W. FROM THE SE COR. SEC. 17
- WELL #2 (WASC 3230): 1510' N. & 320' W. FROM THE SE COR. SEC. 17
- L-97600 — WELL #3 (WASC 51988): 460' N. & 1265' W. FROM THE SE COR. SEC. 17
- WELL #4 (WASC 3223): 1455' N & 1745' W FROM SE COR. SEC 17

- PERMIT G-5495 AREA = 40.0 ACRES
- PERMIT G-10645 AREA = (3.15) ACRES
- 50760): 1415' N & 1745' W FROM SE COR SEC 17

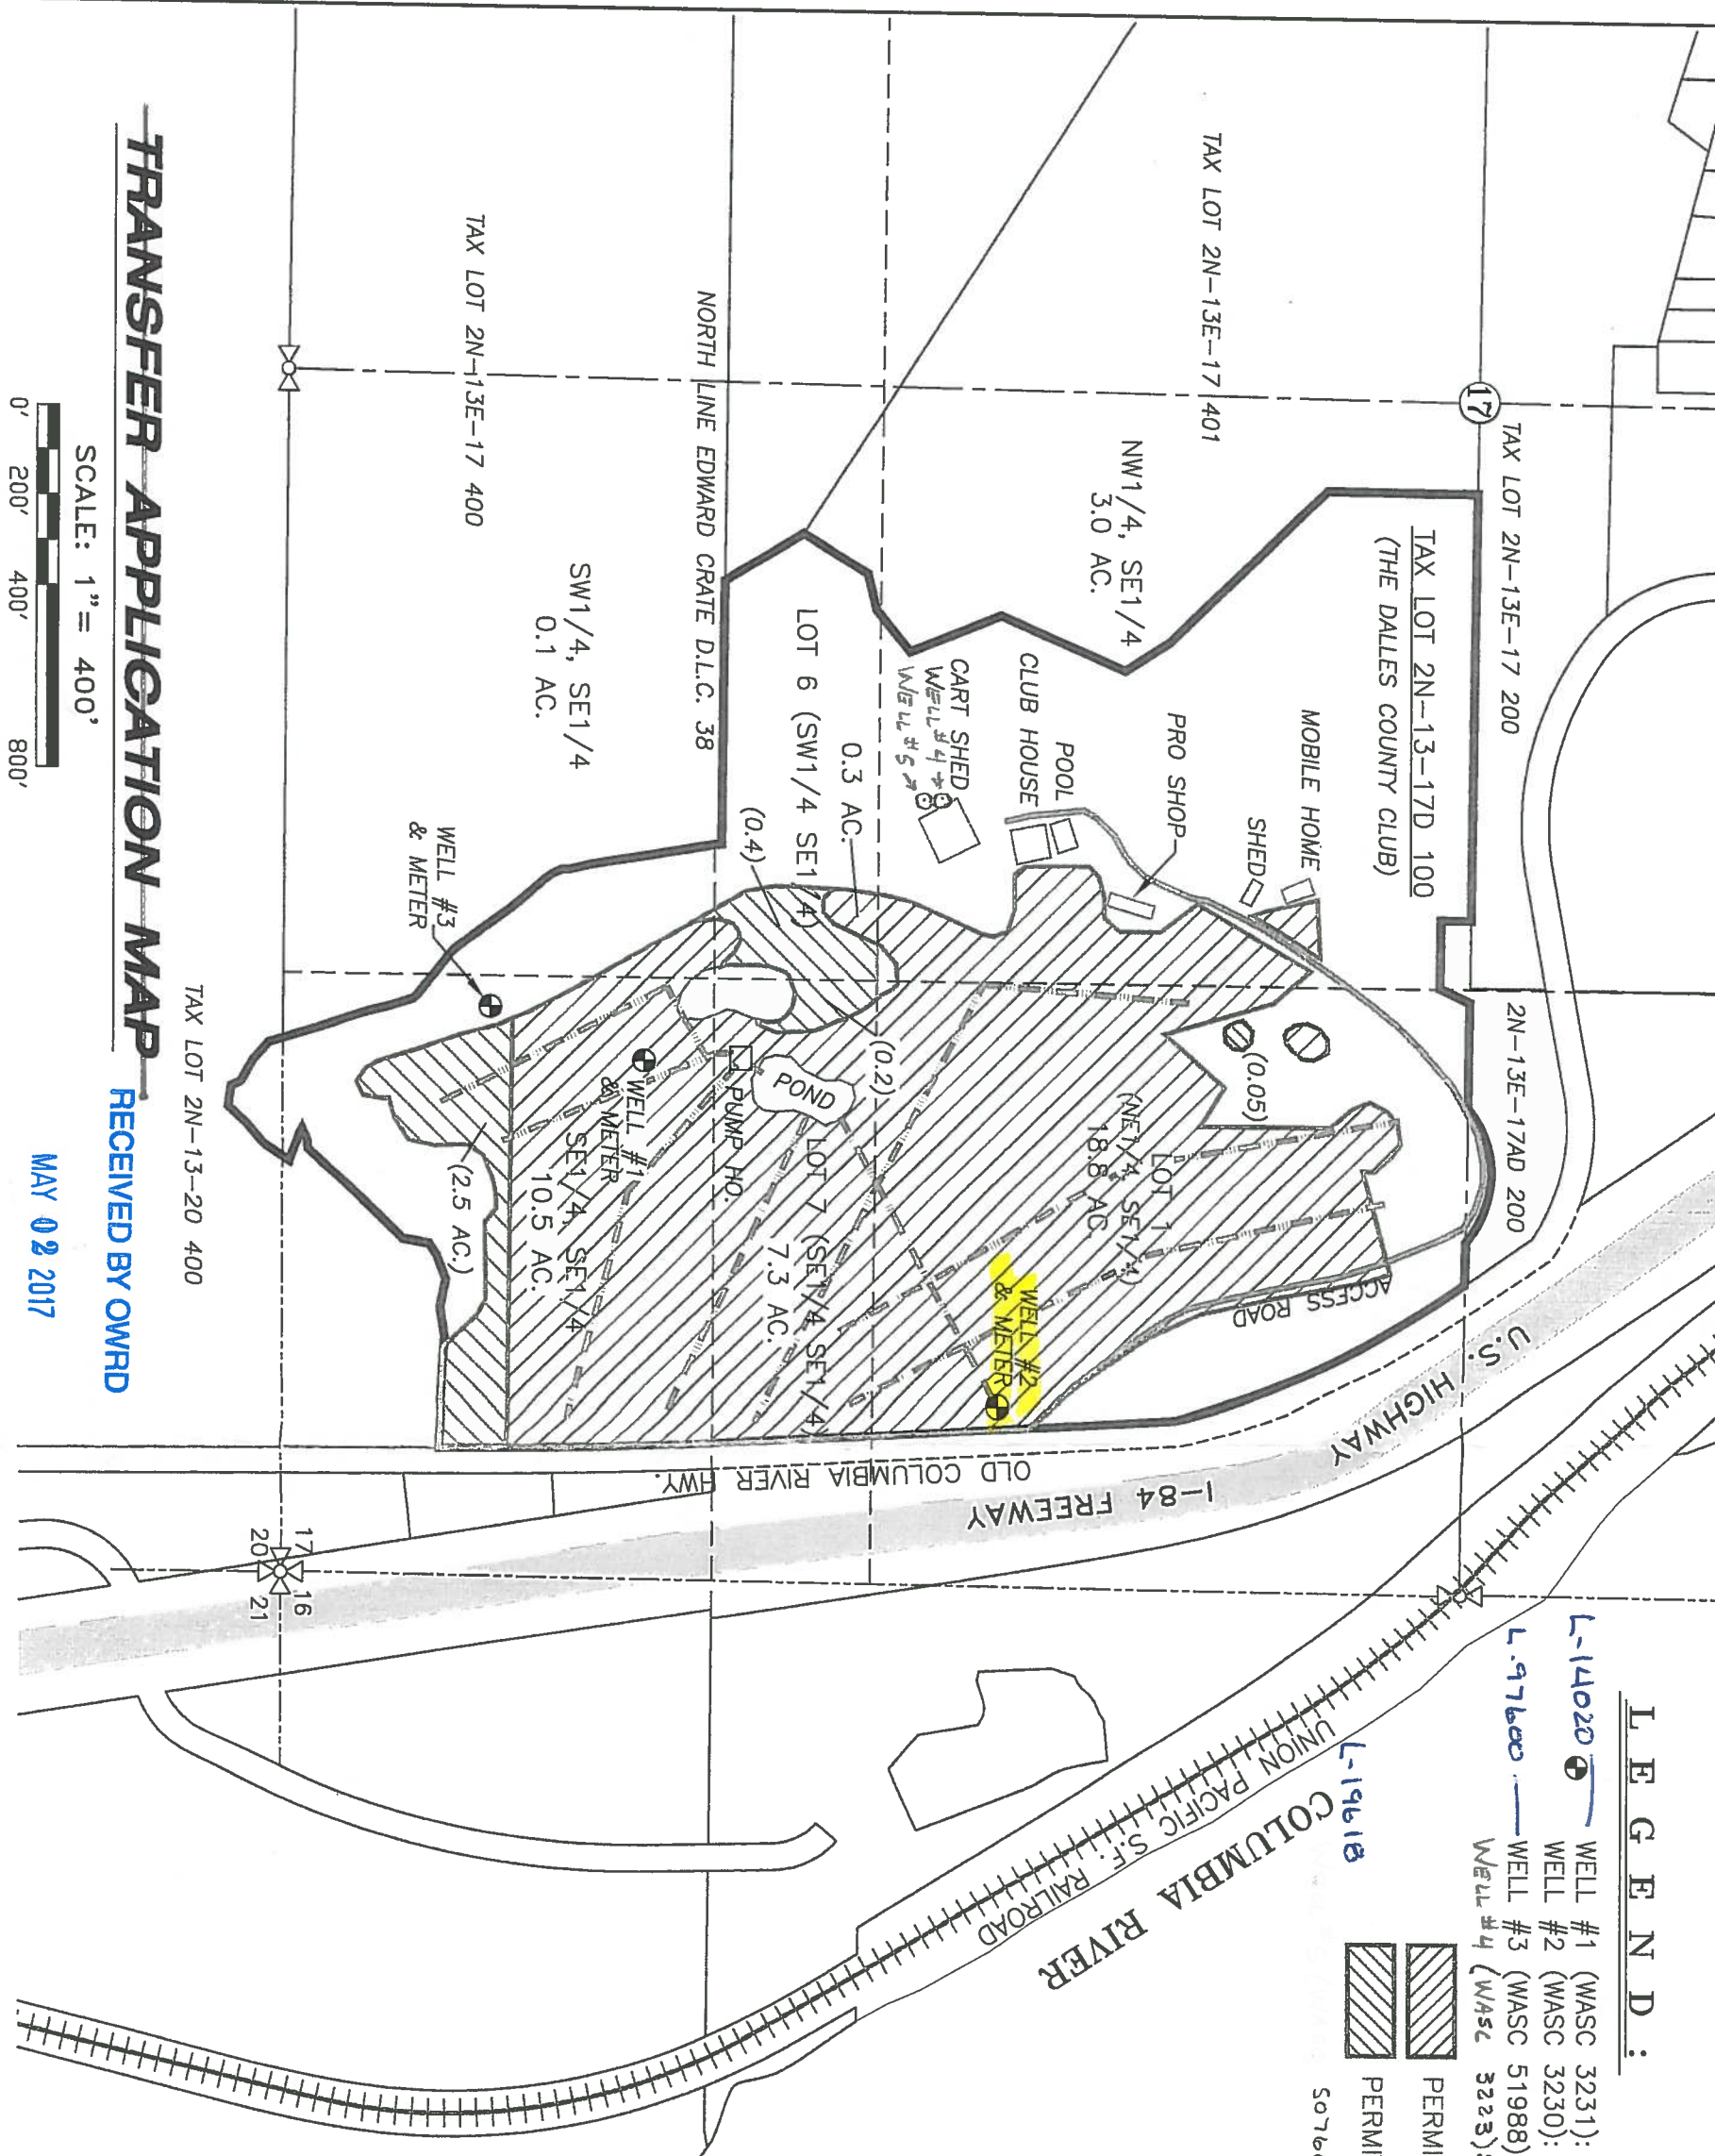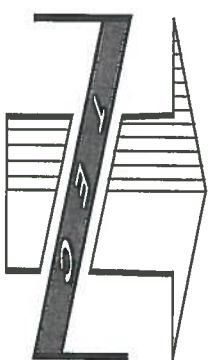

TRANSFER No. 17962  
 IN THE NAME OF:  
THE DALLES COUNTRY CLUB

DATE: DECEMBER 4, 2014  
 AMENDED JULY 2, 2015

BY: **TENNESON ENGINEERING CORP.**  
 3775 CRATES WAY  
 THE DALLES, OREGON. 97058  
 PH. 541-296-9177  
 FAX 541-296-6657



**NOTE:**  
 "THIS MAP IS NOT INTENDED TO  
 PROVIDE DIMENSIONS OR LOCATIONS  
 OF PROPERTY OWNERSHIP LINES."



EXPIRES: 06/30/2016

**TRANSFER APPLICATION MAP** RECEIVED BY OWRD

SCALE: 1" = 400'



MAY 02 2017

SALEM, OR