

STATE ENGINEER
Salem, Oregon

Well Record

STATE WELL NO. 7/39-20N(1)
COUNTY Baker
APPLICATION NO.

OWNER: City of Baker
MAILING ADDRESS:

LOCATION OF WELL: Owner's No.
CITY AND STATE:


SW 1/4 SW 1/4 Sec. 20 T. 7 N. S. R. 39 E. W. W.M.

Bearing and distance from section or subdivision
corner

Altitude at well 3323.80

TYPE OF WELL: Dug Date Constructed

Depth drilled 9 Depth cased 7

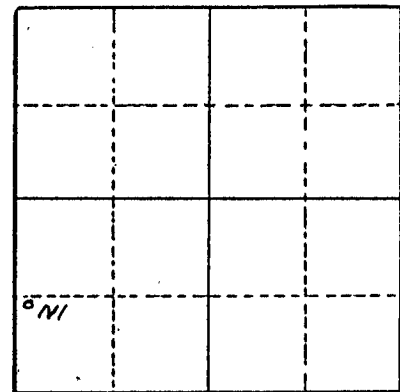

Section 20

CASING RECORD:

Wood crib to 9 feet
12" perforated steel casing from 3 to 7 feet

FINISH:

AQUIFERS:

WATER LEVEL:

PUMPING EQUIPMENT: Type H.P.
Capacity G.P.M.

WELL TESTS:

Drawdown ft. after hours G.P.M.
Drawdown ft. after hours G.P.M.

USE OF WATER Temp. °F. 19

SOURCE OF INFORMATION

DRILLER or DIGGER

ADDITIONAL DATA:

Log Water Level Measurements X Chemical Analysis Aquifer Test

REMARKS:

USGS observation well
See page 235 WSP 817 for description.