


TOWNSHIP 16 SOUTH, RANGE 2 WEST, W.M.

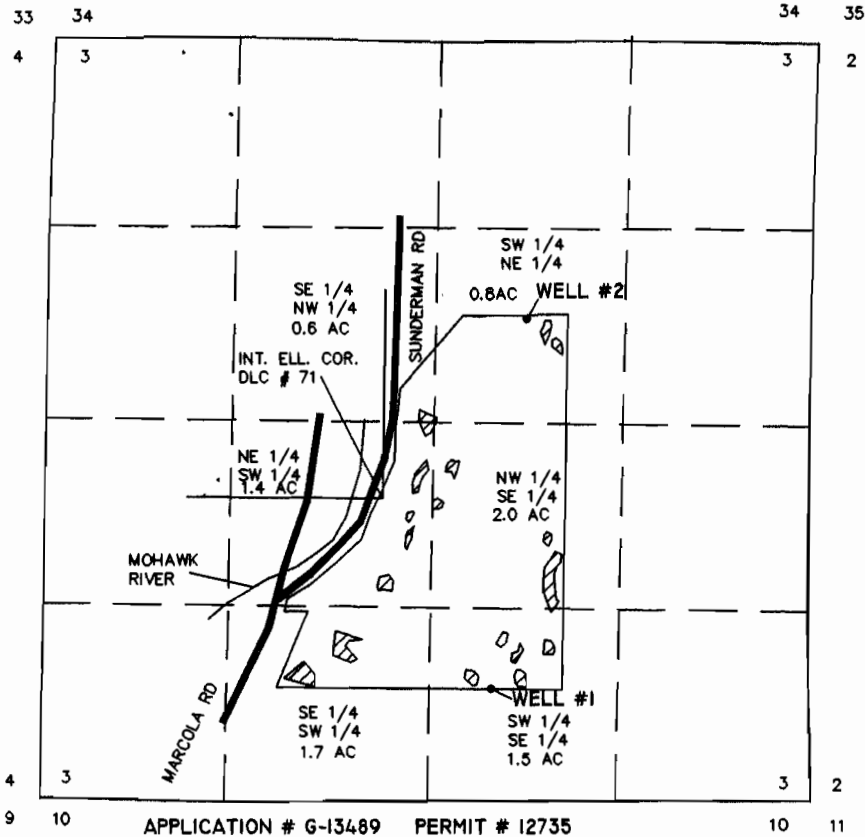


WELL LOCATION:

WELL #1 = S29°25'28"E 1505.88 FEET
 FROM INT. ELL. COR. DLC #71
 WELL #2 = N38°40'29"E 1580.91 FEET
 FROM INT. ELL. COR. DLC #71

 DENOTES AREA OF BENEFICIAL USE

FINAL PROOF SURVEY
 FOR
 SPRINGFIELD COUNTRY CLUB
 90333 SUNDERMAN RD
 SPRINGFIELD, OR 97478
 BY
 FORD-NESS-FASSBENDER, INC.
 PO BOX 22735
 EUGENE, OR, 97408

NOTE:
 THIS MAP WAS PREPARED FOR THE PURPOSE OF
 IDENTIFYING THE LOCATION OF THE WATER RIGHT
 ONLY. IT IS NOT INTENDED TO PROVIDE
 DIMENSIONS OR LOCATION OF PROPERTY
 OWNERSHIP LINES.

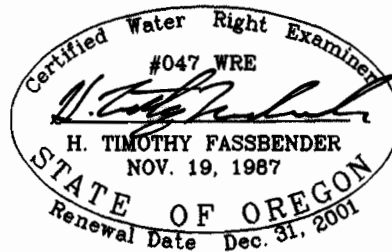

JOB NO. S3755
 DWG NO. S3755.DWG

RECEIVED

SEP 29 2000

WATER RESOURCES DEPT.
 SALEM, OREGON