

acres
C.V.
7/6/2005

SW 1/4 NE 1/4 T. 17 S., R. 4 W. Sec 9

0.36 ac. irr.

4.4 ac. irr.

TAX LOT 1300

Highway 99

Test well

F. Holes

out of service well

4 PLEX

Drain Field

P.O.D.

NEW WELL
SITE 415' s, 812' E of
cntr 1/4 cor.
1st choice


Jonny Owens Properties
89970 Hwy. 99N
Eugene, OR 97402

RECEIVED

JUL 05 2005

WATER RESOURCES DEPT
SALEM, OREGON

Scale
1" = 100'

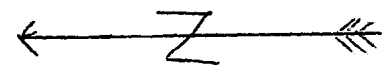

center 1/4 corner

NE 1/4 SW 1/4

