


TAX Lot 500 and 700
 1/4 - 1/2 - 1/4
 SW 1/4 of NW 1/4 and the SE 1/4 of NW 1/4
 1" = 400'

Wells distance from corner 2150' south x 924' east

- = well
- ▨ = Field #1 9.5 ac.
- ▩ = Field #2 1.5 ac
- = 3" Plastic Pipeline

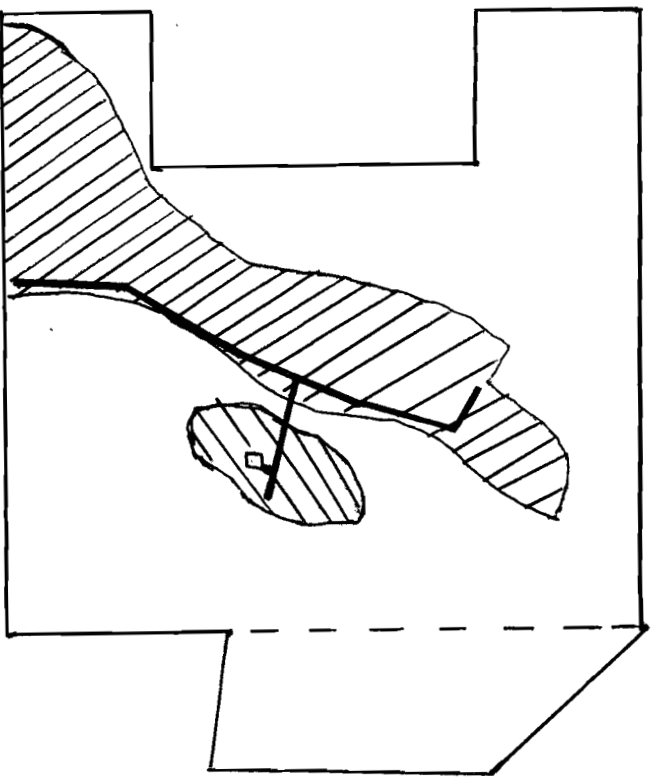

RECEIVED
 JAN 24 2006
 WATER RESOURCES DEPT
 SALEM OREGON