


T.17S., R.12E., W.M.

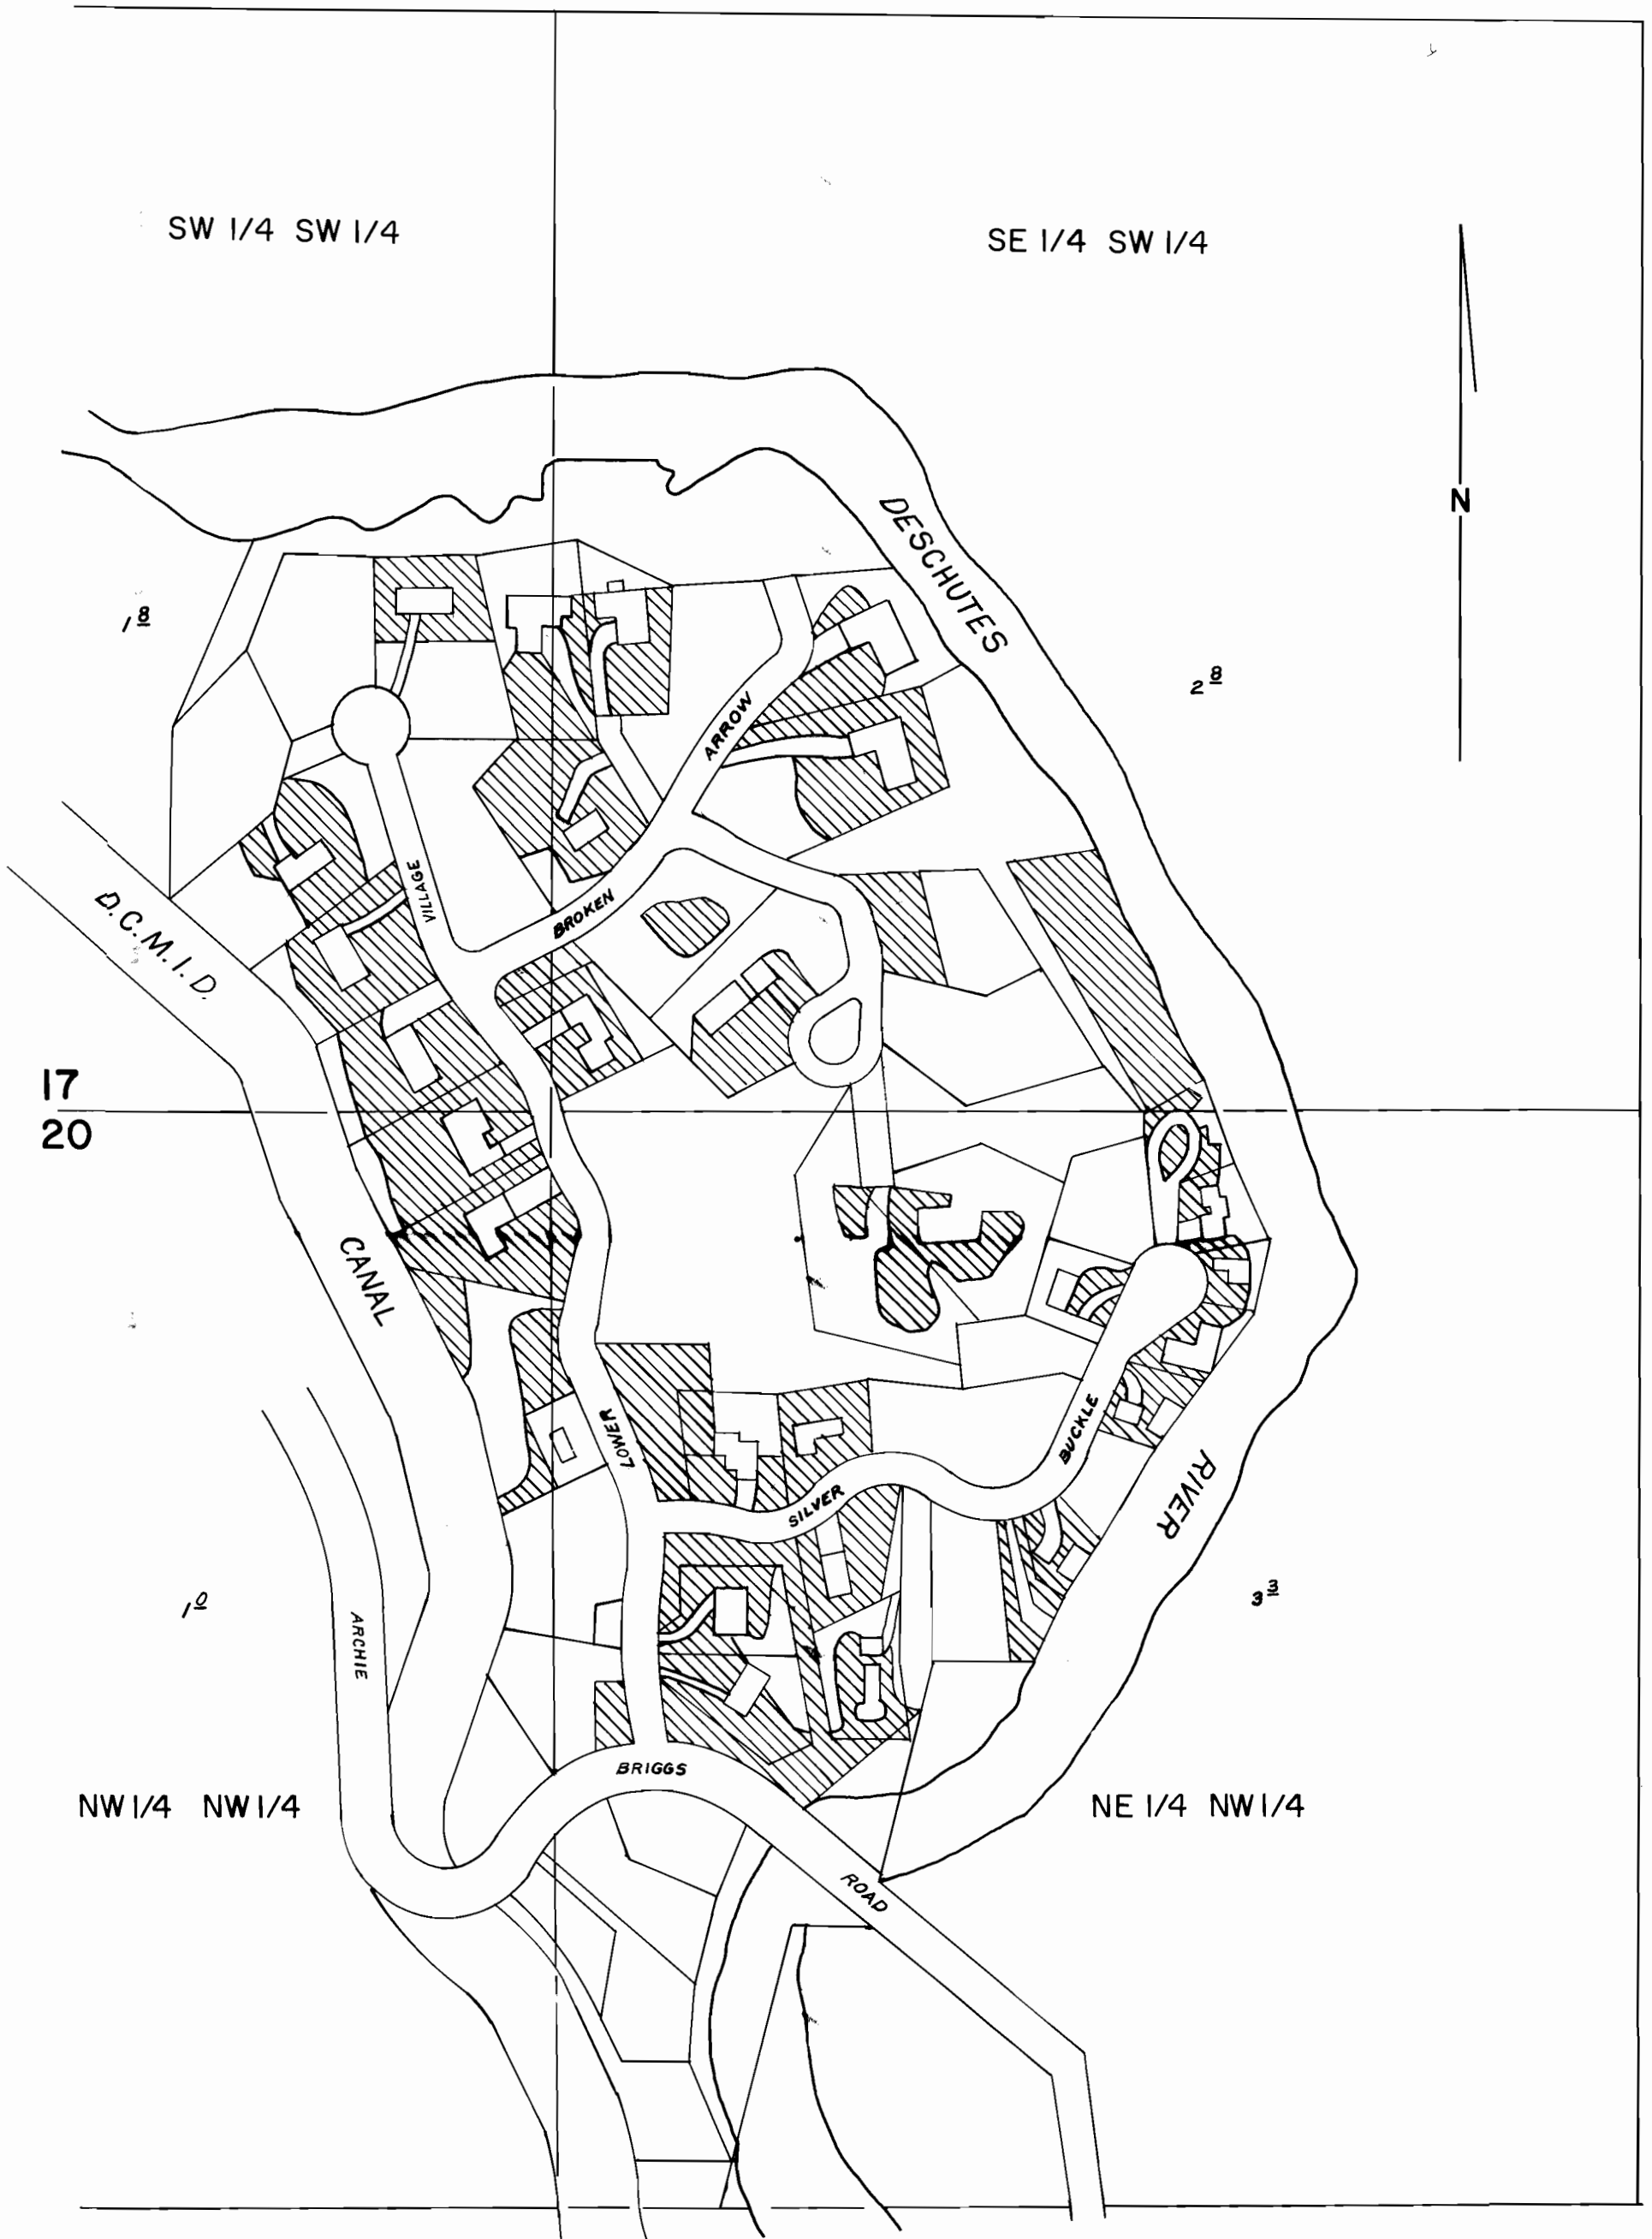

FINAL PROOF SURVEY
UNDER

SCALE: 1" = 200'

TRANSFER NO. 3989 & 3990

RIMROCK WEST SUBDIVISION

SURVEYED JUNE 6, 1985 by LESLIE OLSON