


# T.41S., R.13W., W.M.

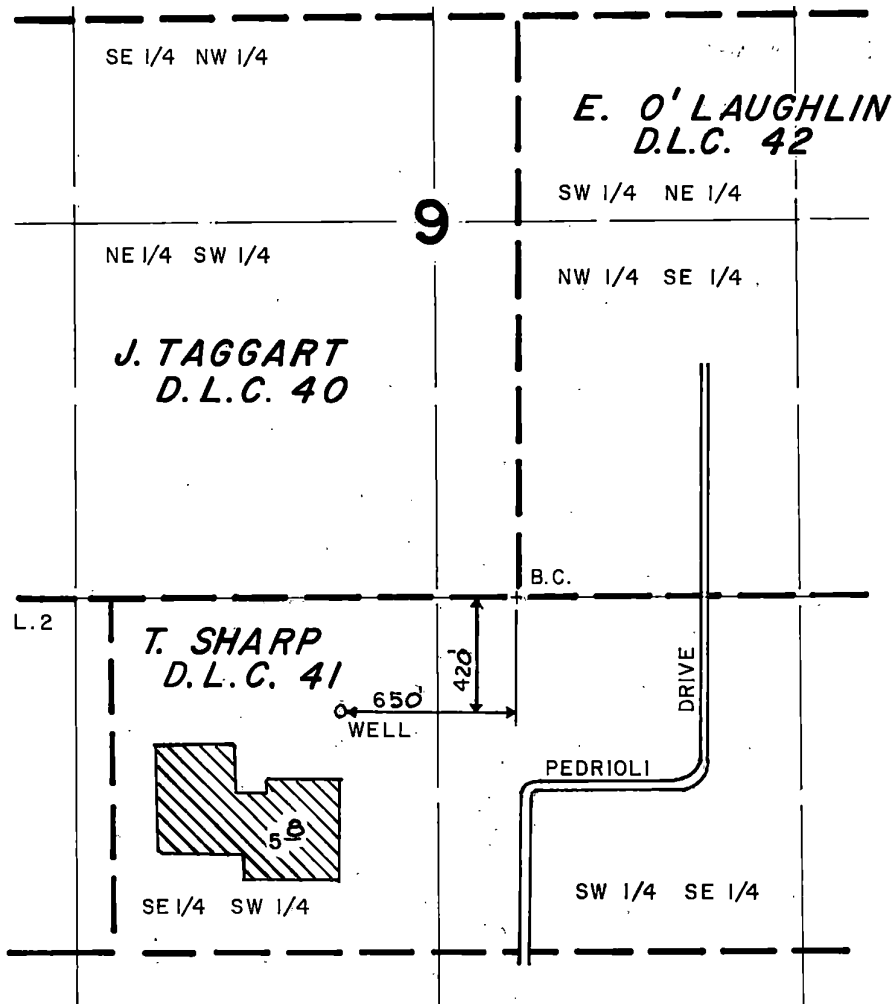

SCALE: 8" = 1 MILE

## FINAL PROOF SURVEY UNDER

Application No. G-7402 Permit No. G-7085  
IN NAME OF

PETER COWAN

Surveyed APRIL 10 1985, by L.E. CASHION