


APPLICATION MAP

IN THE NAME OF: GEORGE C. REINMILLER
SEC. 10, T3N, R8W, W.M.
TILLAMOOK COUNTY
MARCH 25, 1993

RECEIVED

JAN 19 1994

WATER RESOURCES DEPT.
SALEM, OREGON

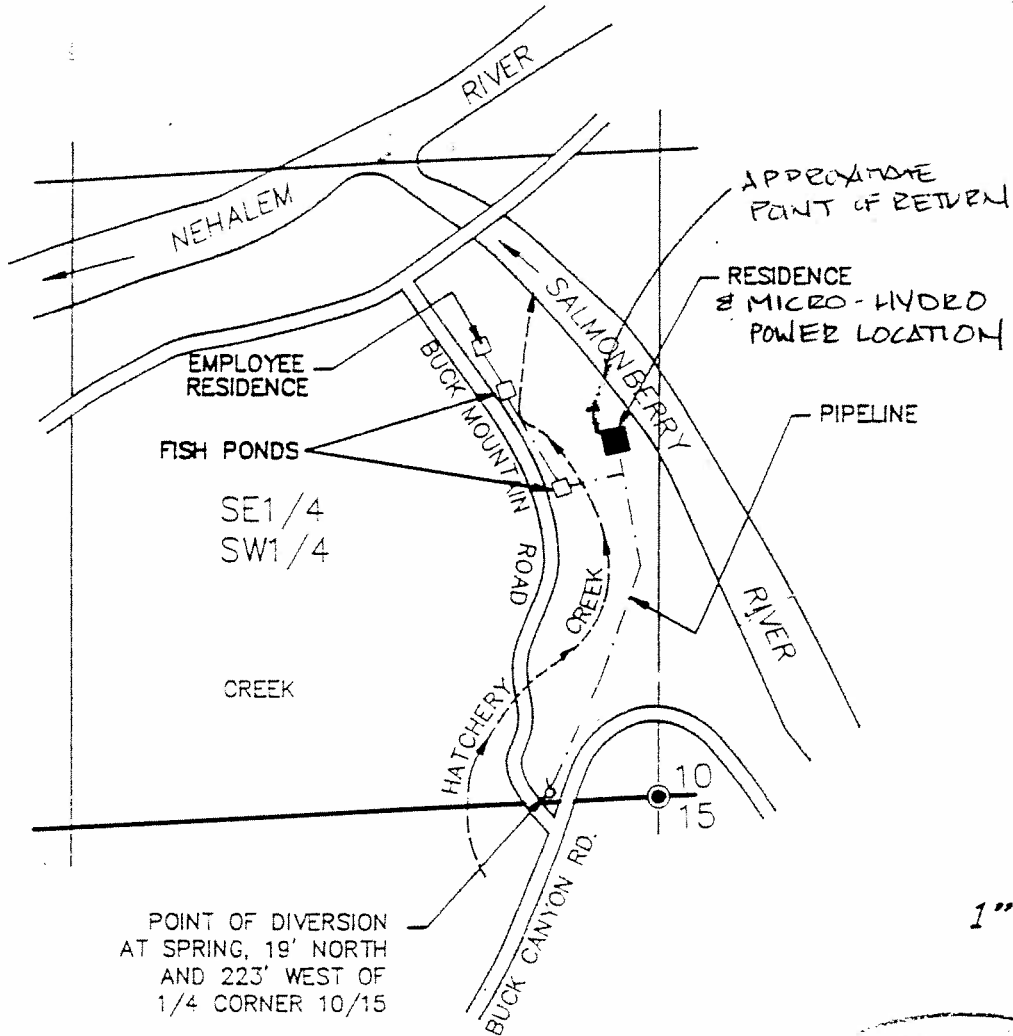

SCALE:

1" = 400'

Ronald A. Larson

FILE: REIN-WRA.DWG

THE PURPOSE OF THIS MAP IS TO IDENTIFY THE LOCATION OF THE WATER RIGHT. IT IS NOT INTENDED TO PROVIDE INFORMATION RELATIVE TO THE LOCATION OF PROPERTY OWNERSHIP BOUNDARY LINES.

HANDFORTH LARSON & BARRETT, INC.

P.O. BOX 219

MANZANITA, OR 97130

(503) 368-5394

FAX (503) 368-5847