


Jay and Jan Wheelhouse
April 2011

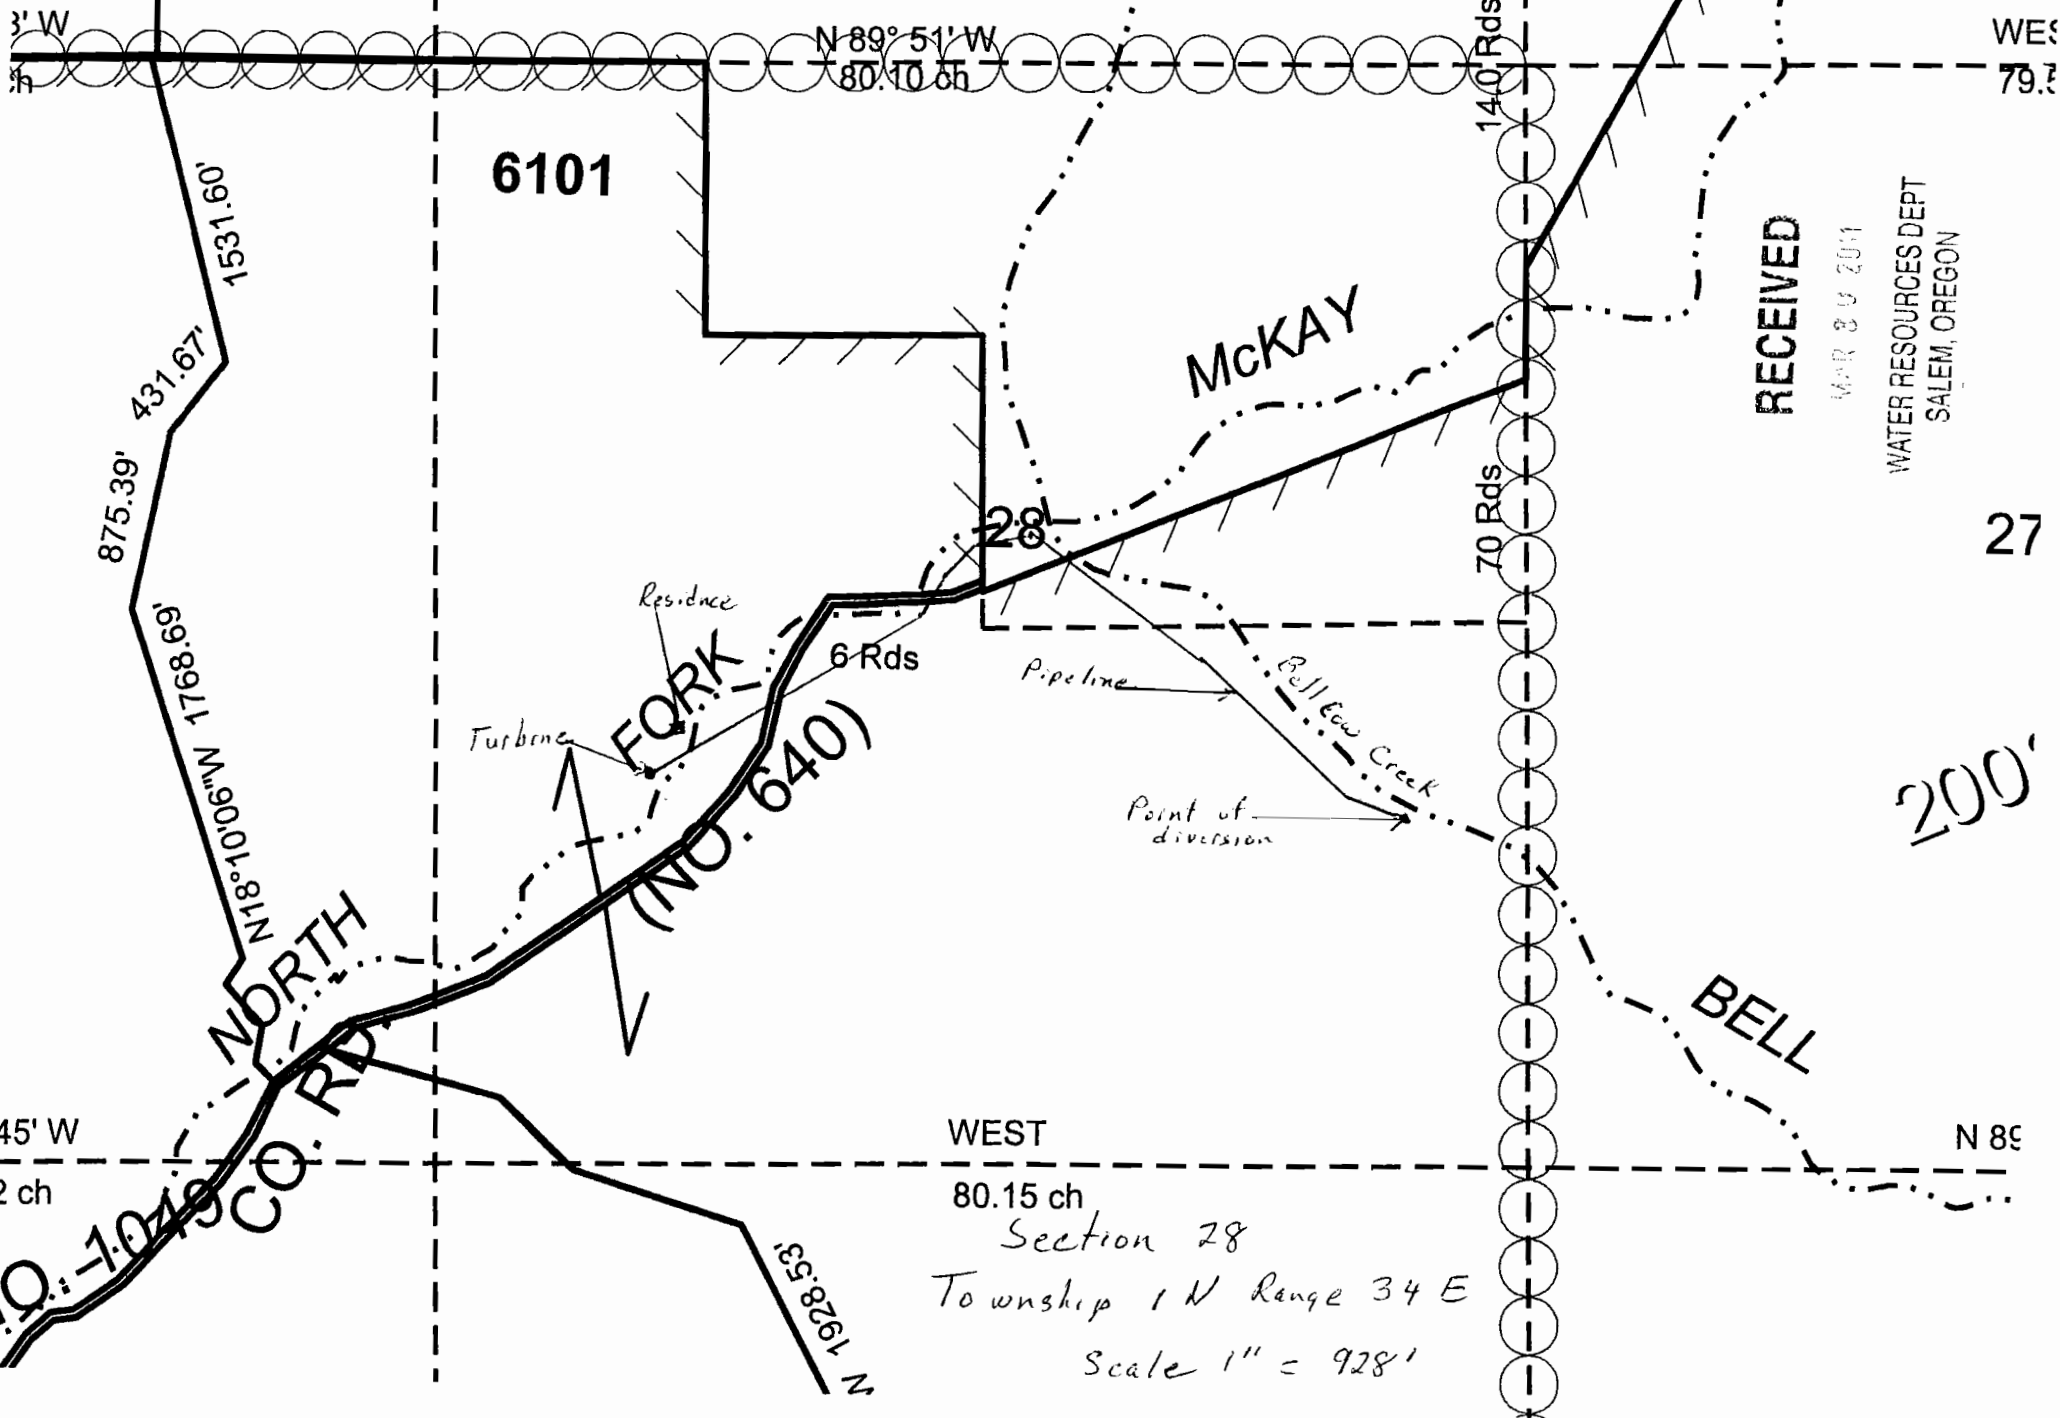

6101

McKAY

FORK
(NO. 640)

BELL

RECEIVED

MAR 20 2011

WATER RESOURCES DEPT
SALEM, OREGON

27

200'

Section 28
Township 1 N Range 34 E
Scale 1" = 928'

3' W

WEST

N 89° 51' W

80.10 ch

79.3

140 Rds

70 Rds

6 Rds

28

1531.60'

431.67'

875.39'

1768.66'

N 18° 10' 0" W

NORTH

CO. RD.

Residence

Turbine

Pipeline

Point of diversion

Bull Cow Creek

WEST

80.15 ch

N 89°

45' W

12 ch

NO. 1049

1928.53' N