


See Map 13 1W

55-15

CS 20742

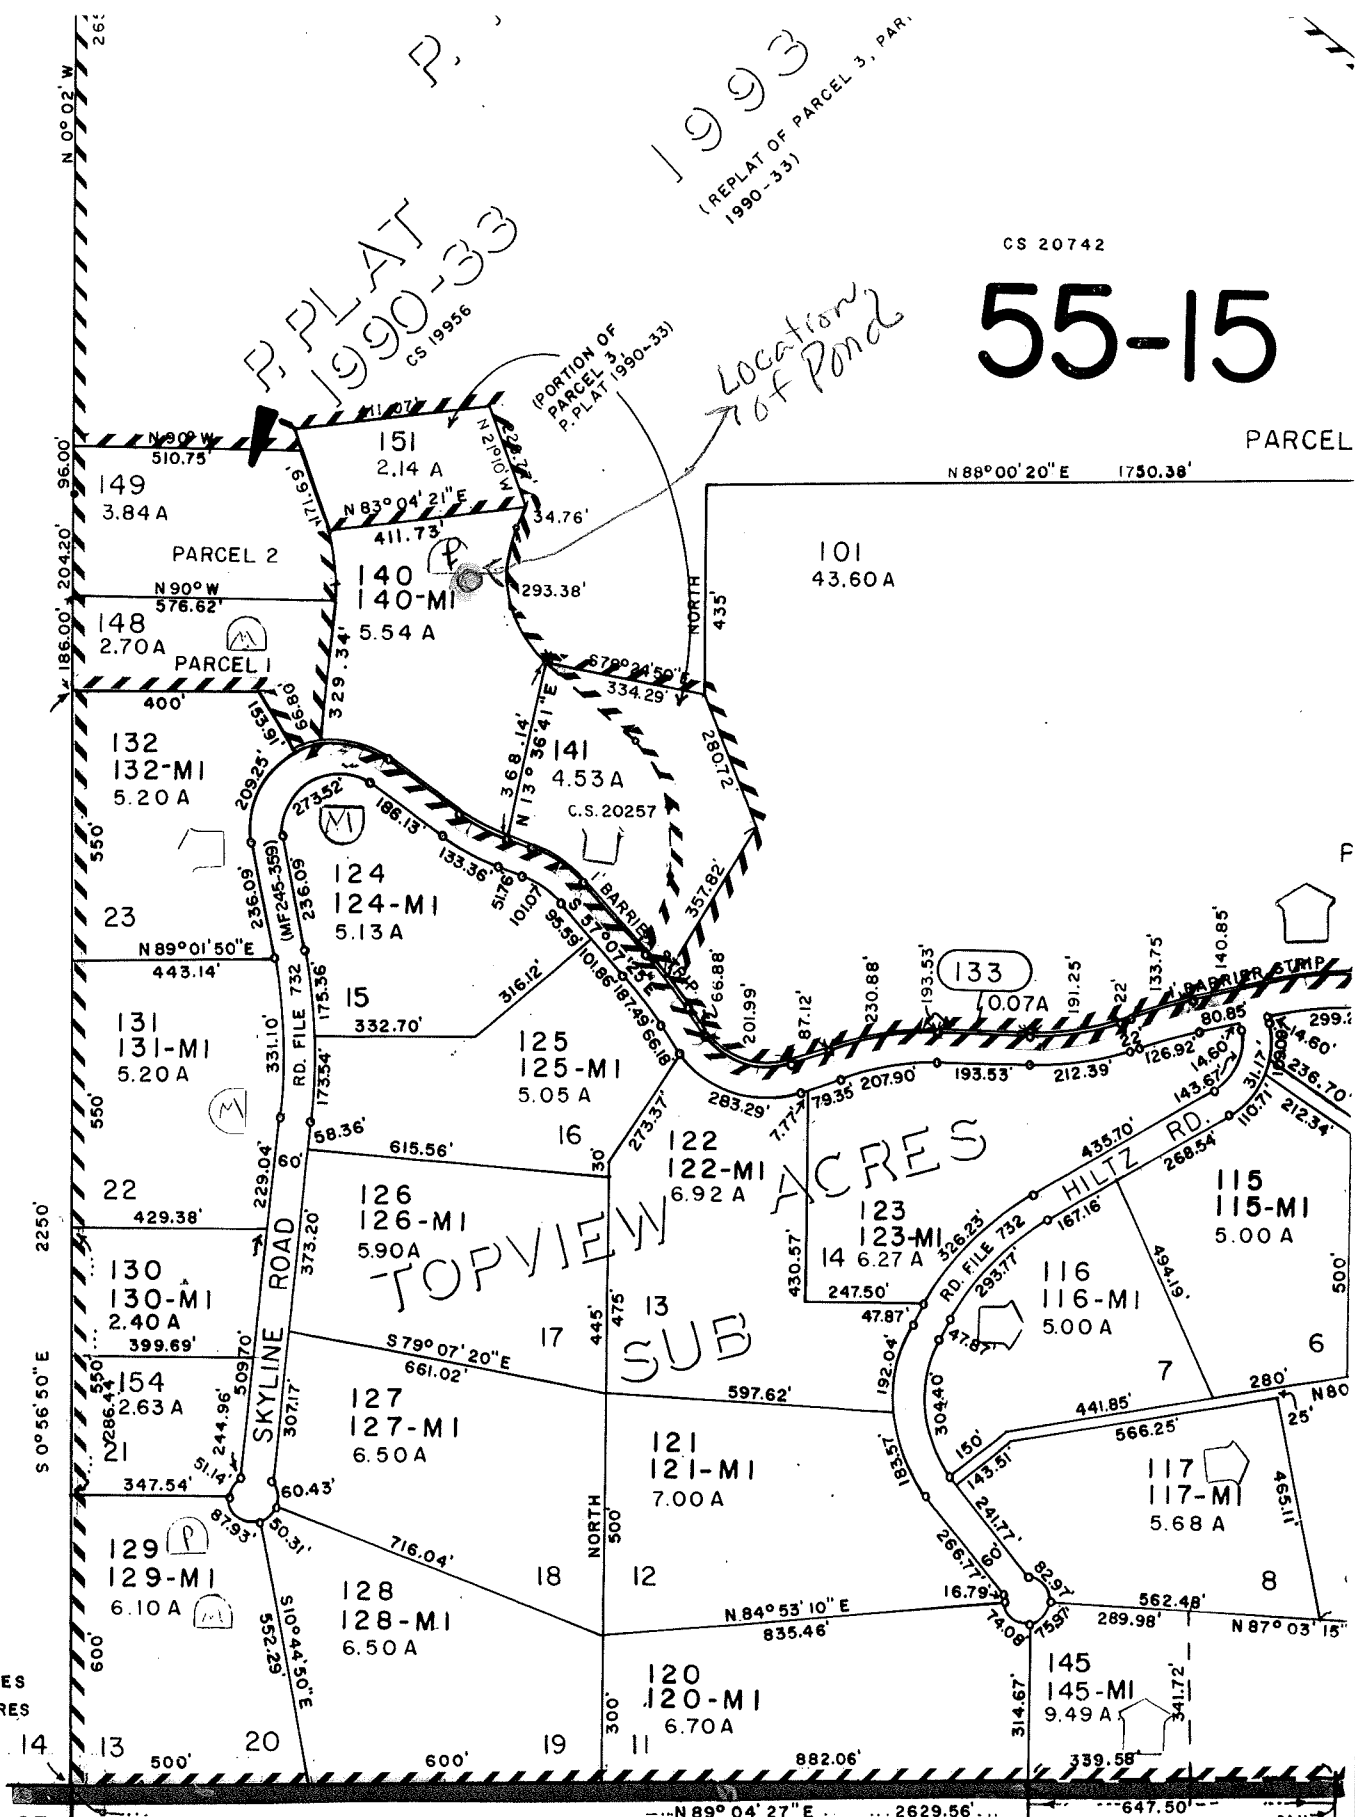

SW NW

P. PLAT 1990-33
CS 19956

1993
(REPLAT OF PARCEL 3, PAR. 1990-33)

Location of Pond

TOPVIEW ACRES
SUB

& SOUTH SECTION LINES
BASED ON TOPVIEW ACRES
VISION PLAT.

55-13

Application No. *P-77393*

Permit No.

See Map

135-1W-13

