


T. 32 S.R.6 W.W.M.

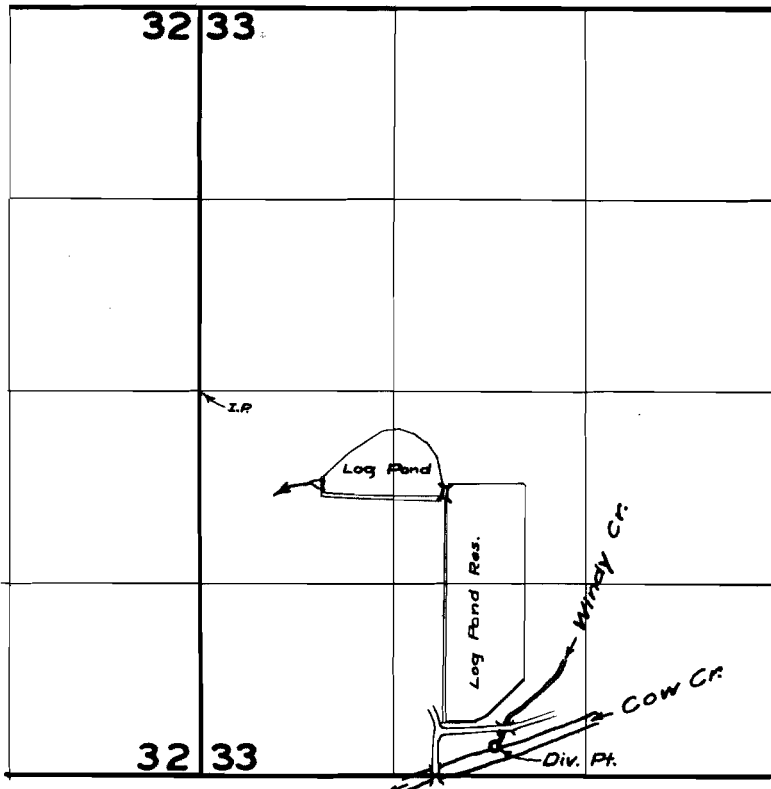

FINAL PROOF SURVEY
UNDER

Application No. ^{R-24333}~~23892~~ Permit No. ^{R-1831}~~24058~~
IN NAME OF

The Robert Dollar Co.

Surveyed *3 Sept.* 1958, by *M. Bish*