


T. 19 & 20 S. R. 34 E. W. M.

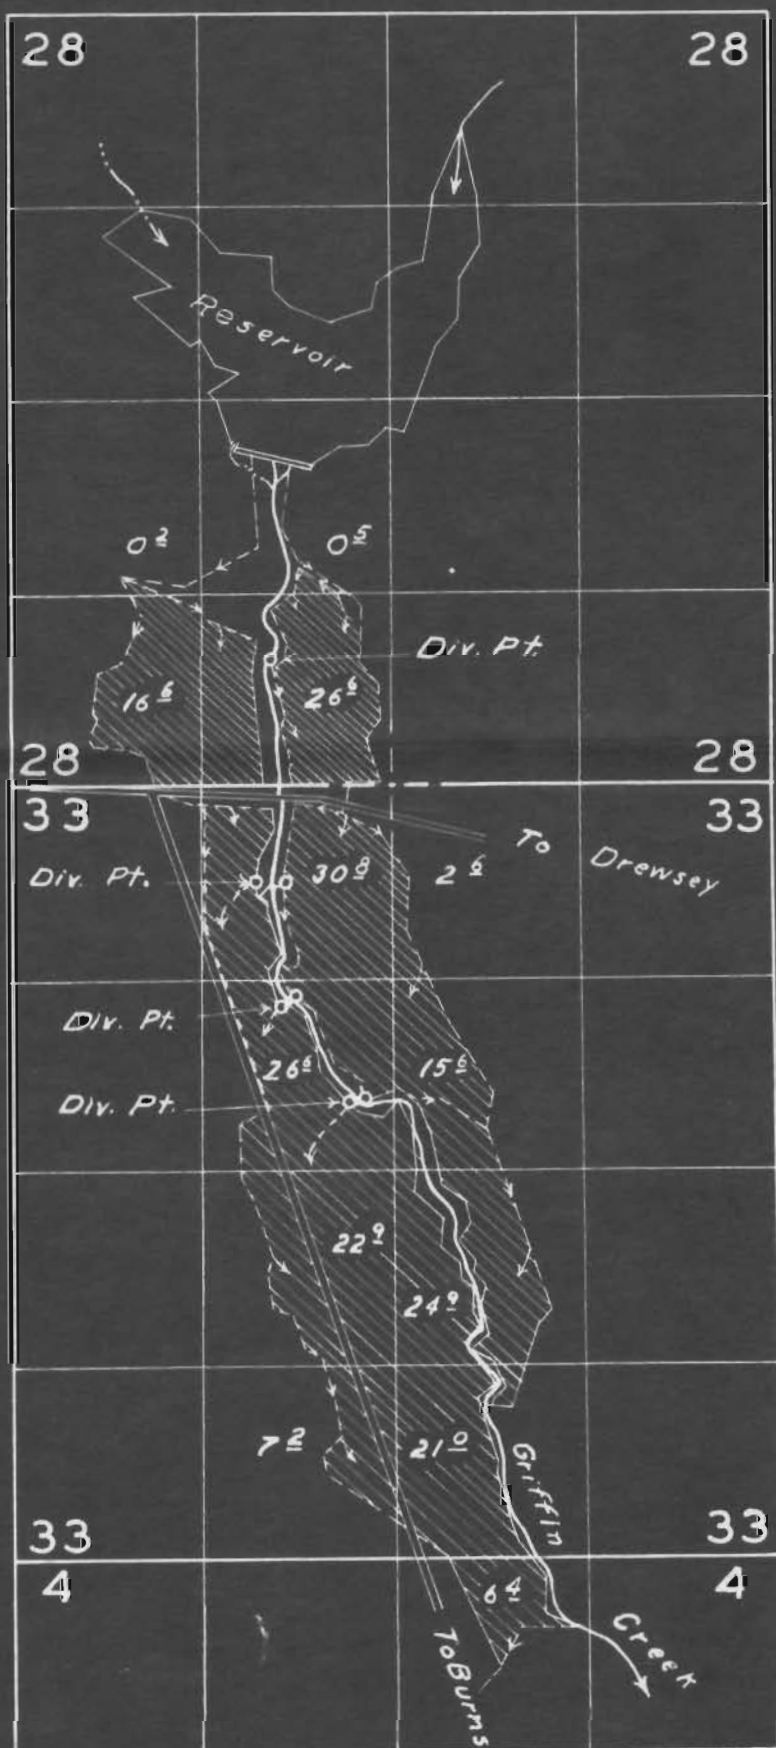

FINAL PROOF SURVEY  
UNDER

APPL. NO. R 24925  
 24926 PERMIT NO. R 1048  
 R 26551 19590  
 26552 R 1312  
 21007

IN NAME OF  
 JOEL C. SWORD  
 SURVEYED AUG. 15, 17 1958 BY W. N. PERRY