


T.16S.R.4E.W.M.

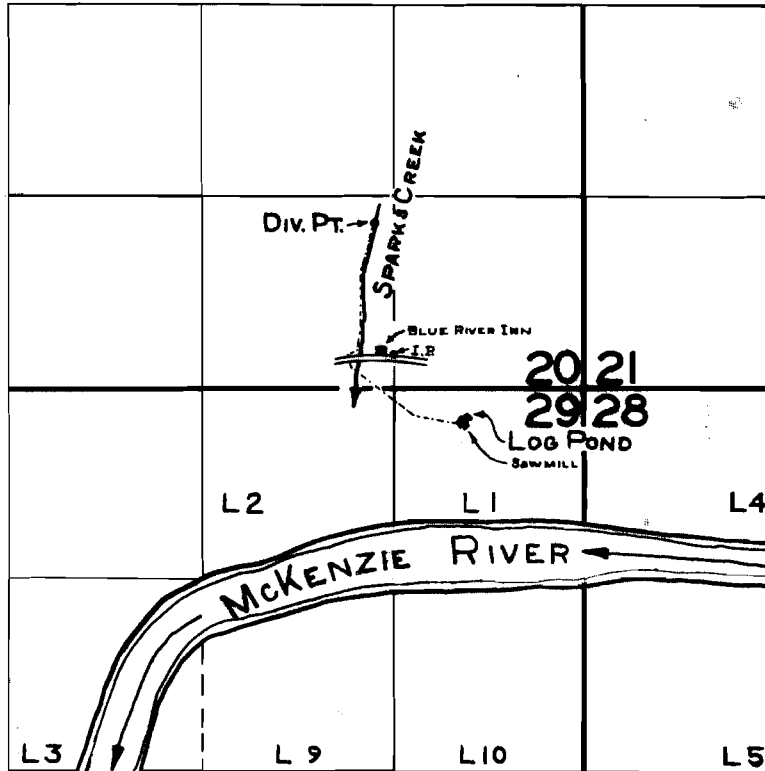

FINAL PROOF SURVEY UNDER

Application No. ^{R-30222} ~~30323~~ Permit No. ^{R-1769} ~~23735~~
IN NAME OF

..... **PHILLIP C. MCGOVERN**

Surveyed SEPT. 2 1960, by M. BISH.....