


T. 1S. R. 3E. W.M.

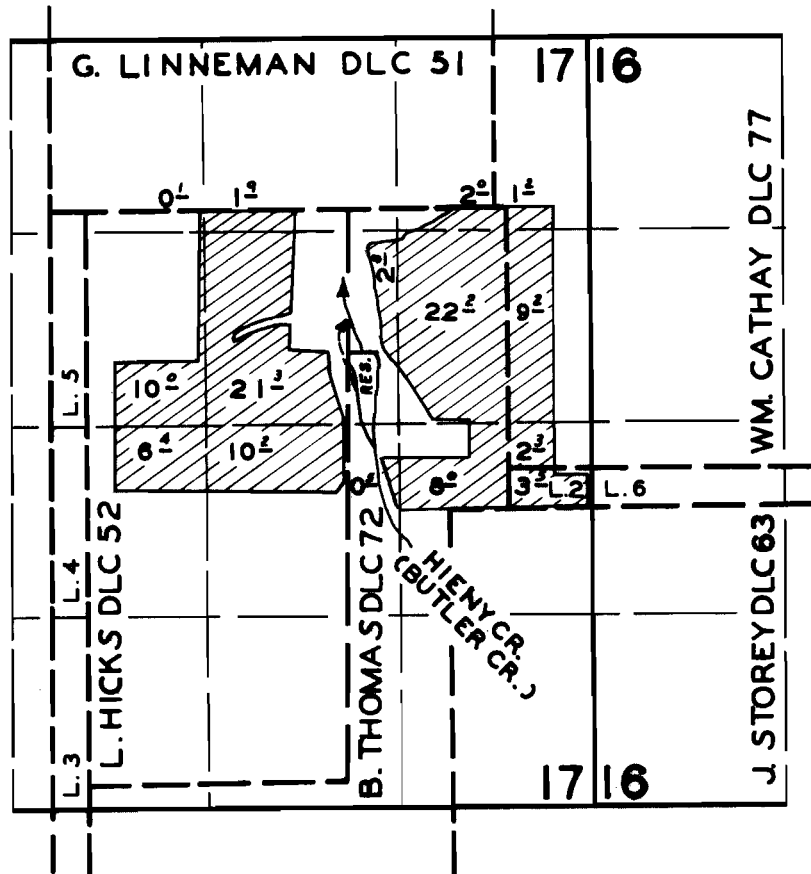

FINAL PROOF SURVEY
UNDER

Application No. 30660 R.30735 Permit No. 24173 R.1.862
IN NAME OF

PETER A. BINFORD

Surveyed MAY 10 1960, by C.O. BARTELS