


T. 37 S. R. 6 W. W. M.

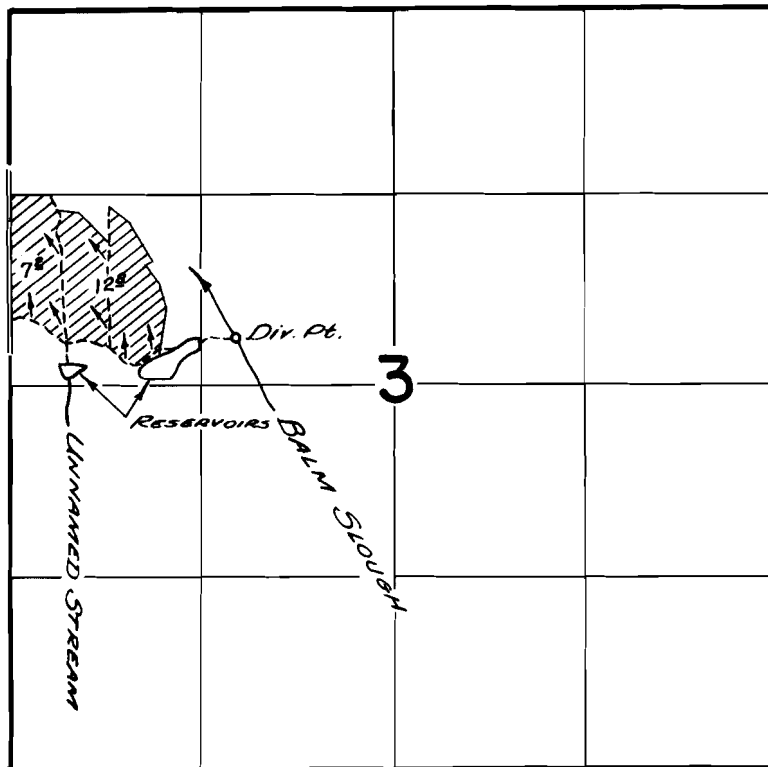

FINAL PROOF SURVEY UNDER

Application No. ^{R-32321} ~~32450~~ Permit No. ^{R-2155} ~~25627~~
IN NAME OF

.....
Surveyed APRIL 11 1961, by C. O. Partridge.....