


# T. 3 S. R. 4 & 5 W. W. M.

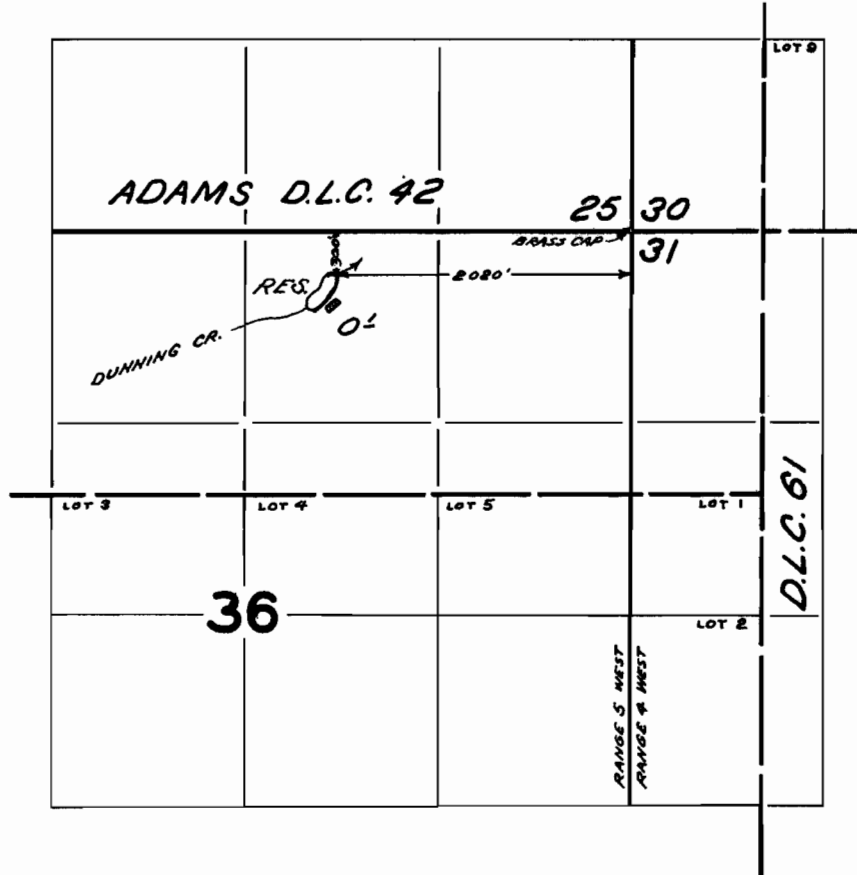

## FINAL PROOF SURVEY UNDER

Application No. 34479 ~~R-34894~~ Permit No. 27316 ~~R-2614~~  
IN NAME OF

ROBERT R. LUOTO

Surveyed MAY 7 1967, by V. GARNER