


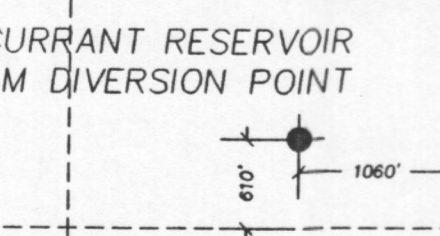
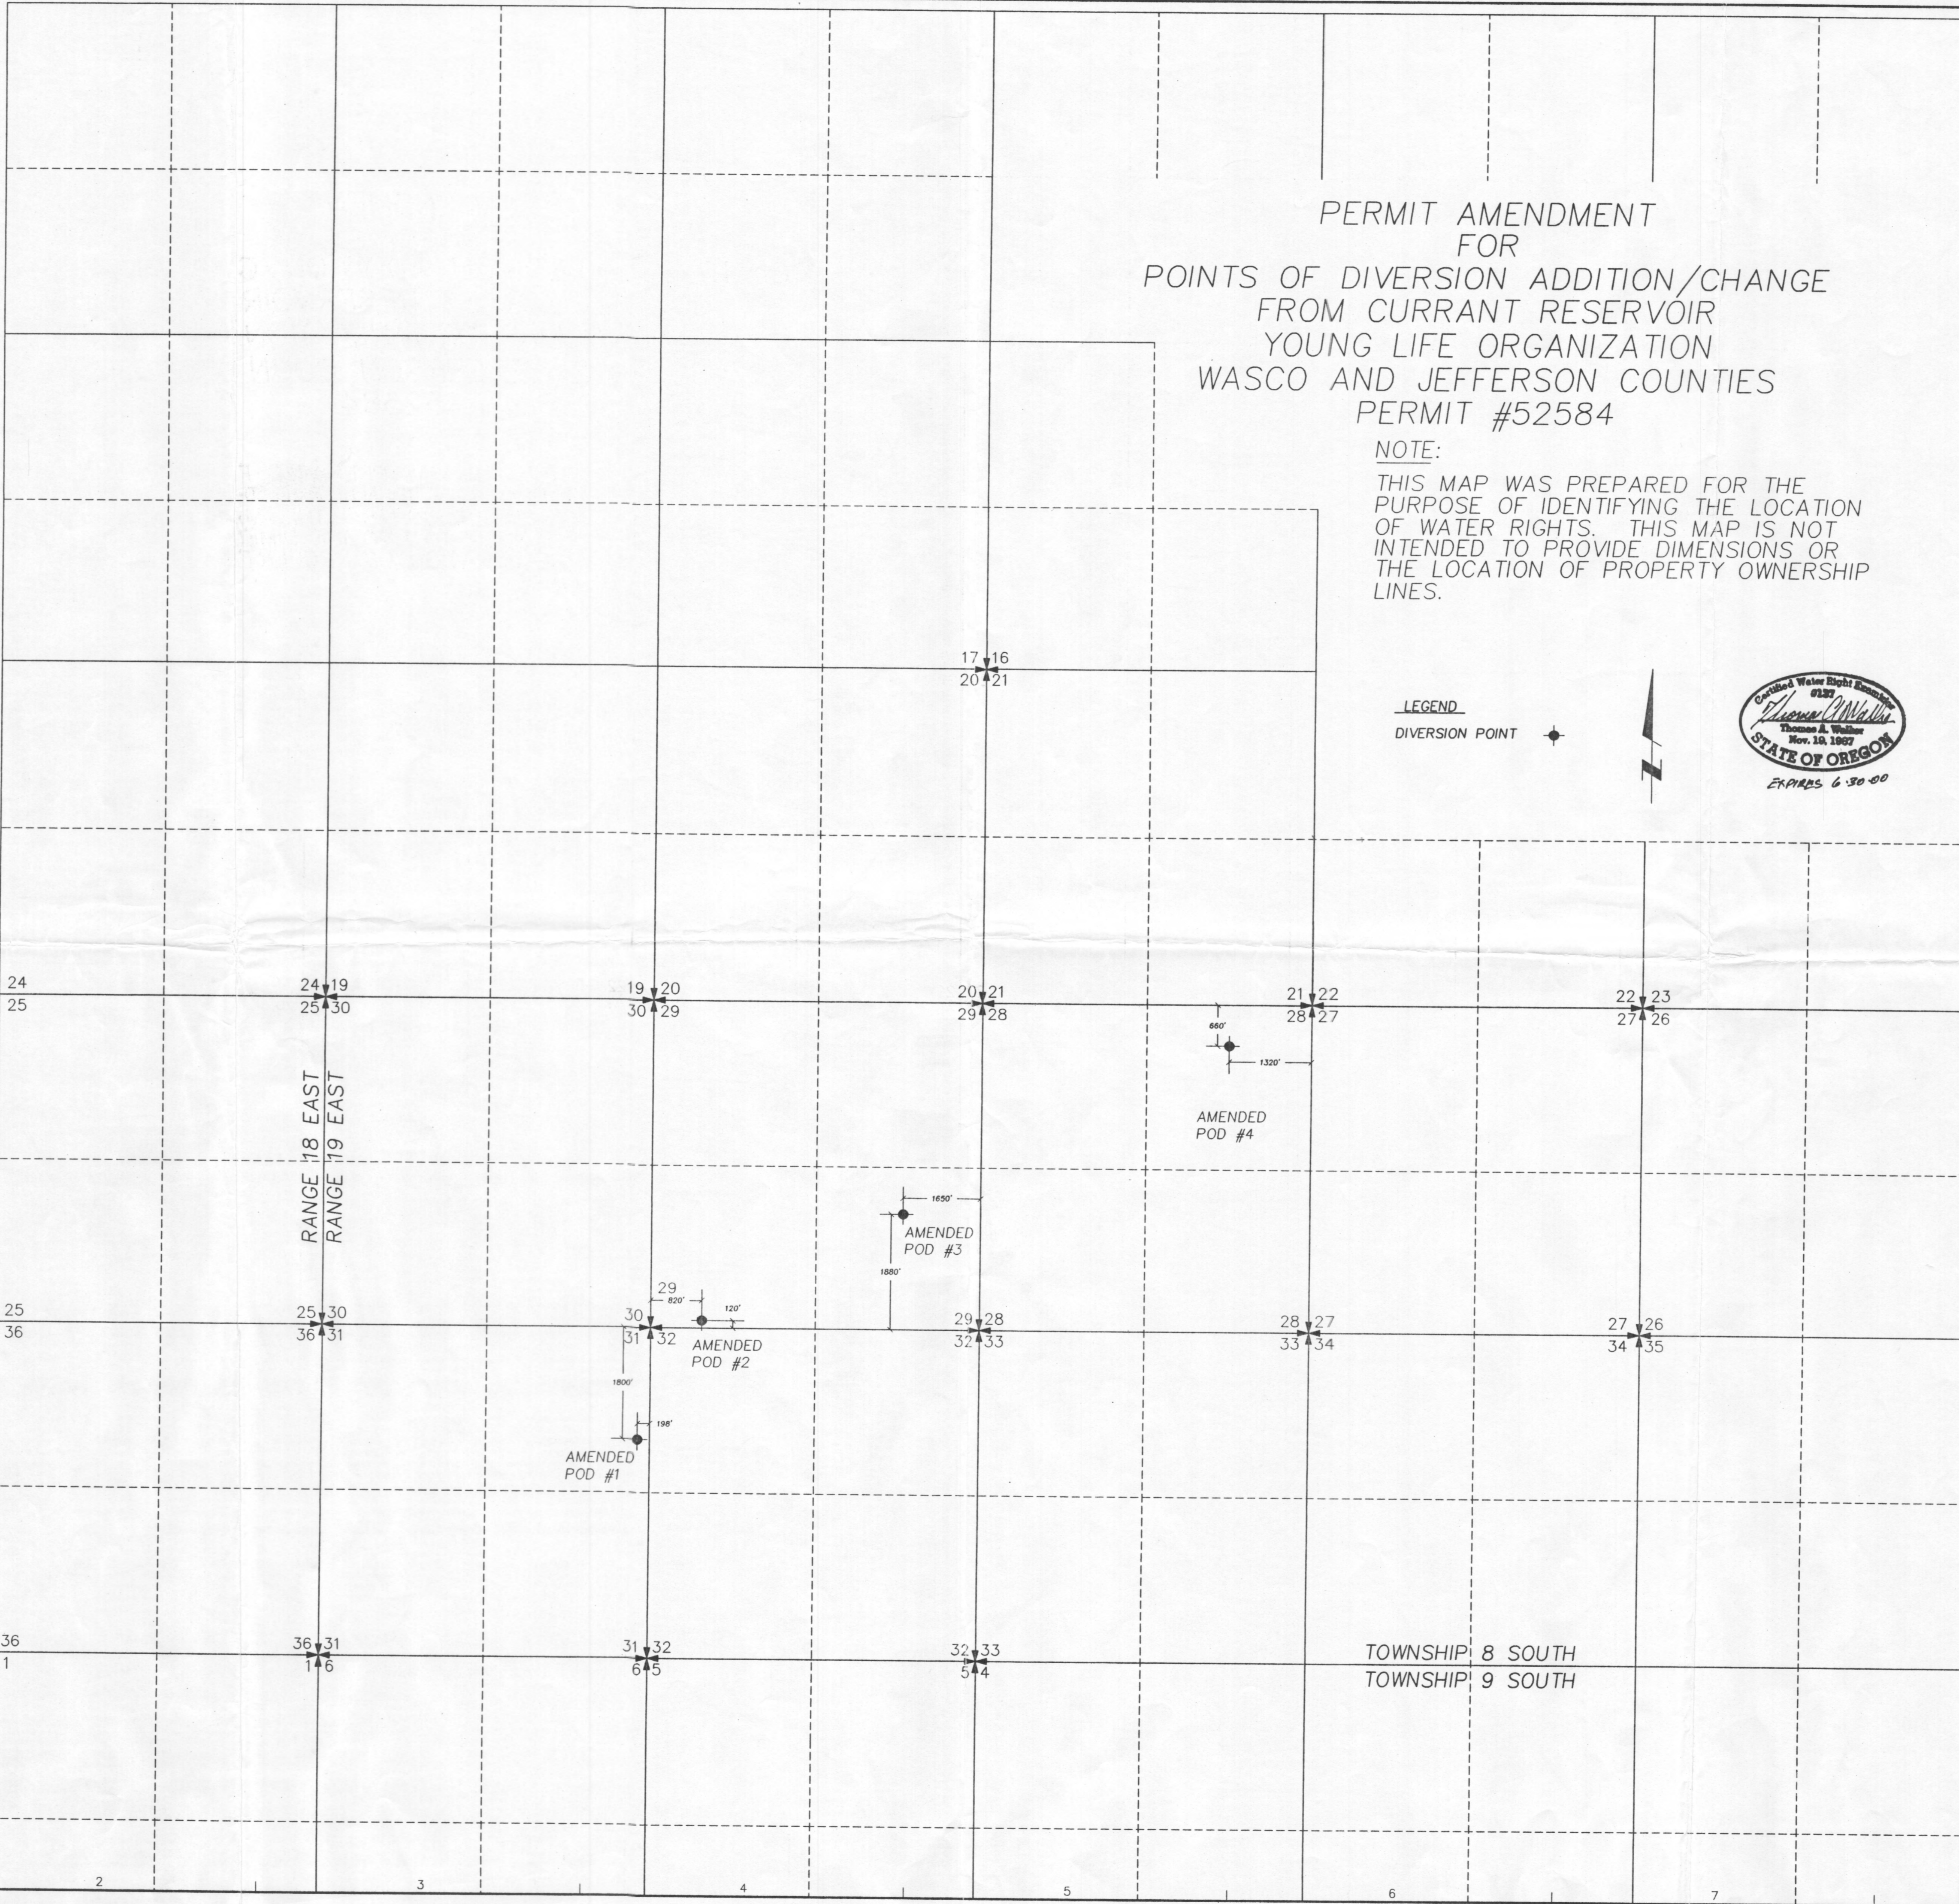
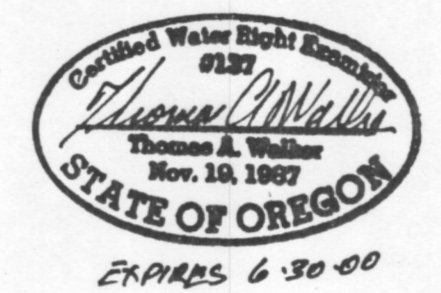
PERMIT AMENDMENT
 FOR
 POINTS OF DIVERSION ADDITION/CHANGE
 FROM CURRANT RESERVOIR
 YOUNG LIFE ORGANIZATION
 WASCO AND JEFFERSON COUNTIES
 PERMIT #52584

NOTE:

THIS MAP WAS PREPARED FOR THE
 PURPOSE OF IDENTIFYING THE LOCATION
 OF WATER RIGHTS. THIS MAP IS NOT
 INTENDED TO PROVIDE DIMENSIONS OR
 THE LOCATION OF PROPERTY OWNERSHIP
 LINES.

LEGEND

DIVERSION POINT 



TOWNSHIP 8 SOUTH
 TOWNSHIP 9 SOUTH

T-8558

EXHIBIT 3
 RECEIVED

JUN 27 2000

WATER RESOURCES DEPT.
 SALEM, OREGON