Application No. R-83917
Permit No. [illegible]

RECEIVED
AUG 17 1998
WATER RESOURCES DEPT.
SALEM, OREGON

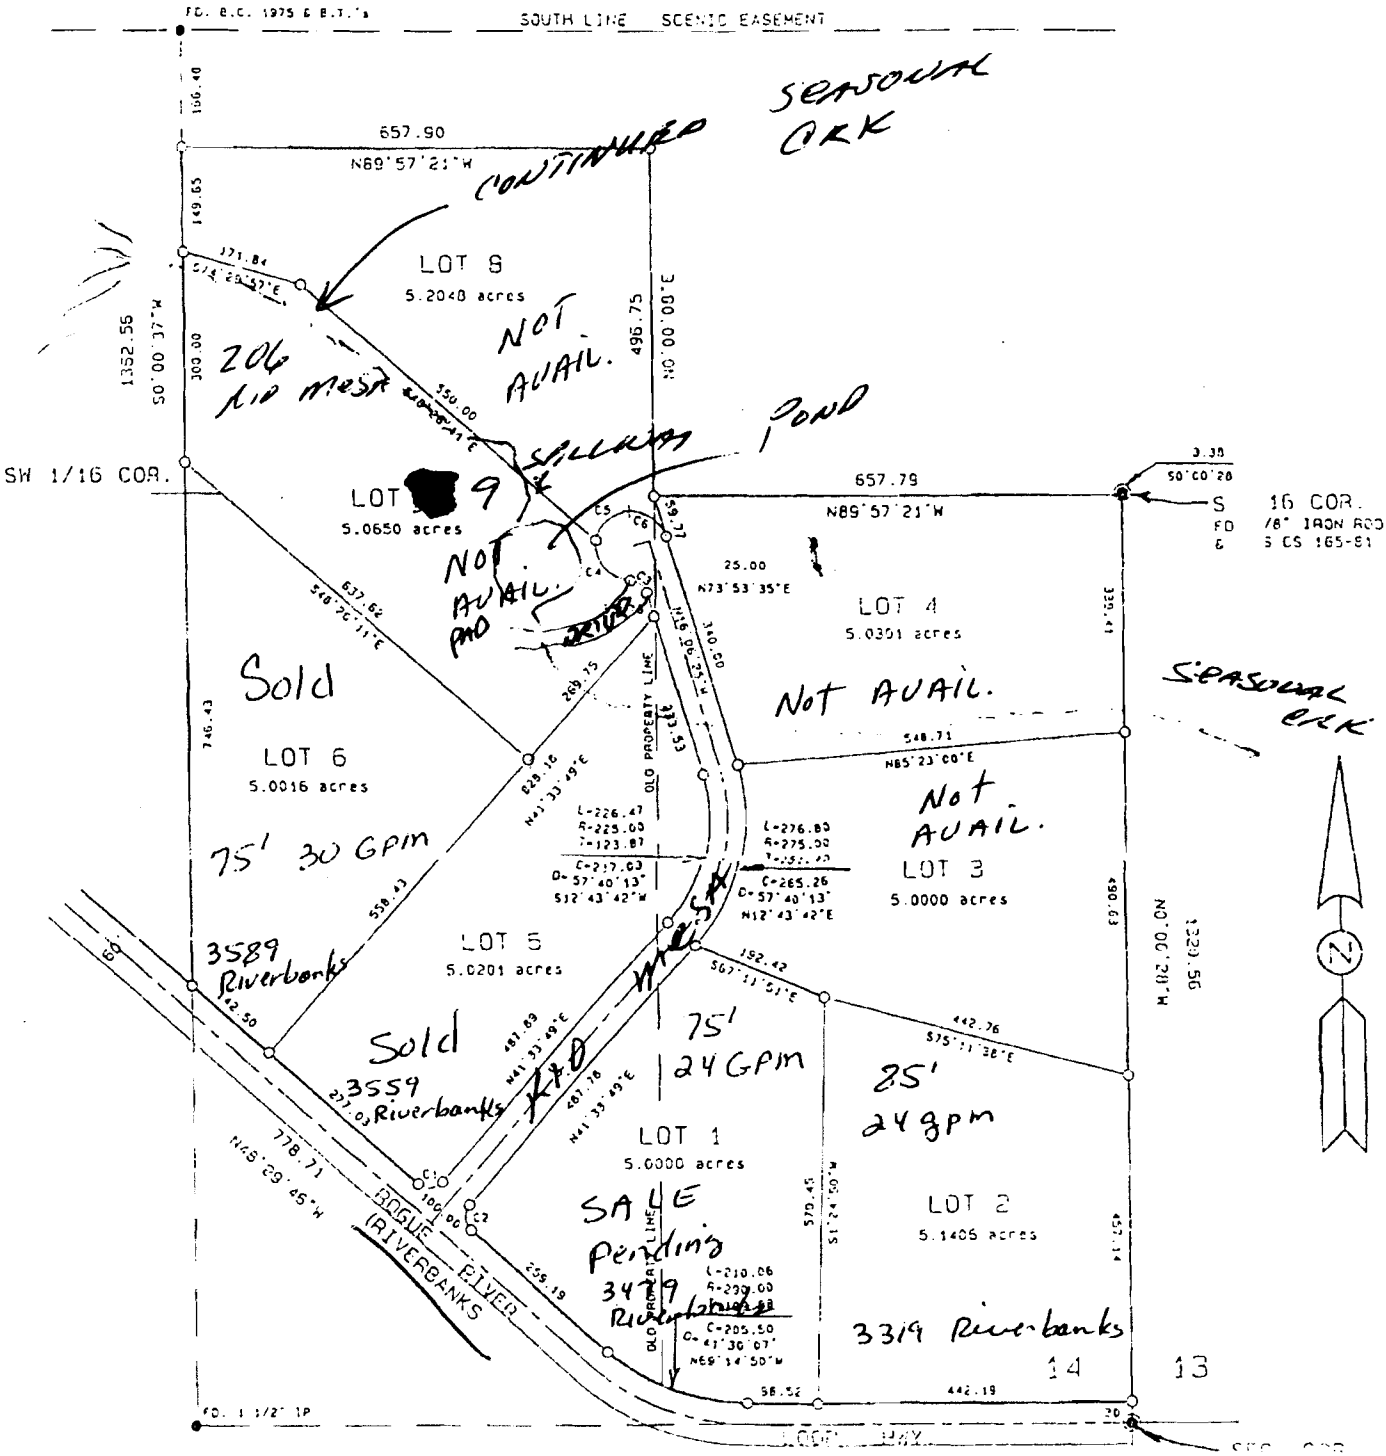

Well Info & Addressed

RECEIVED BY OWRD
AUG 13 2014
SALEM, OR