


Application No. R-84354
Permit No. R-84353

SCALE 1:9600

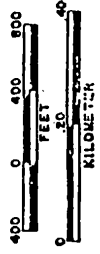

RECEIVED BY OWRD

FEB 20 2015

SALEM, OR

SEC MAP NO 9 5 2

RECEIVED
MAR - 1 2000
WATER RESOURCES DEPT
SALEM, OR

SCALE 1" = 800'

POND #2


P.O.D Located
540' S + 1160' W of NW Corner
+ section 1

SEC. 1 T8SR6WWM
POLK COUNTY

SCALE 1" = 400'

- Proposed place of use
- section corner
- Quarter corner

8 6 1

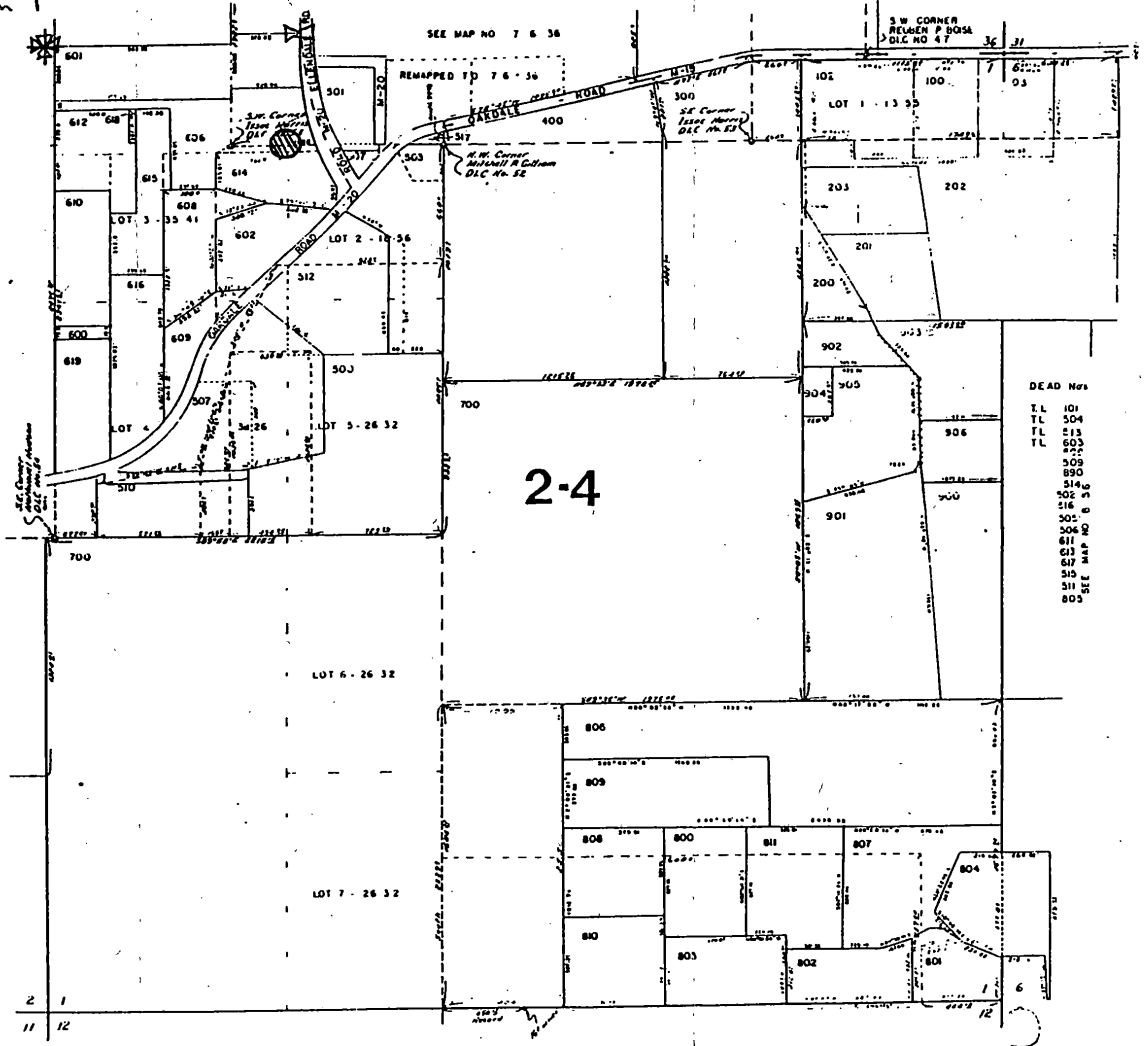

DEAD Nos

TL	101
Application # updated by Dept. Info/Wrd 5-24-16 / Measured distance directional added to 1160 East East 1160