


T.15S. R.44 & 45E. WM

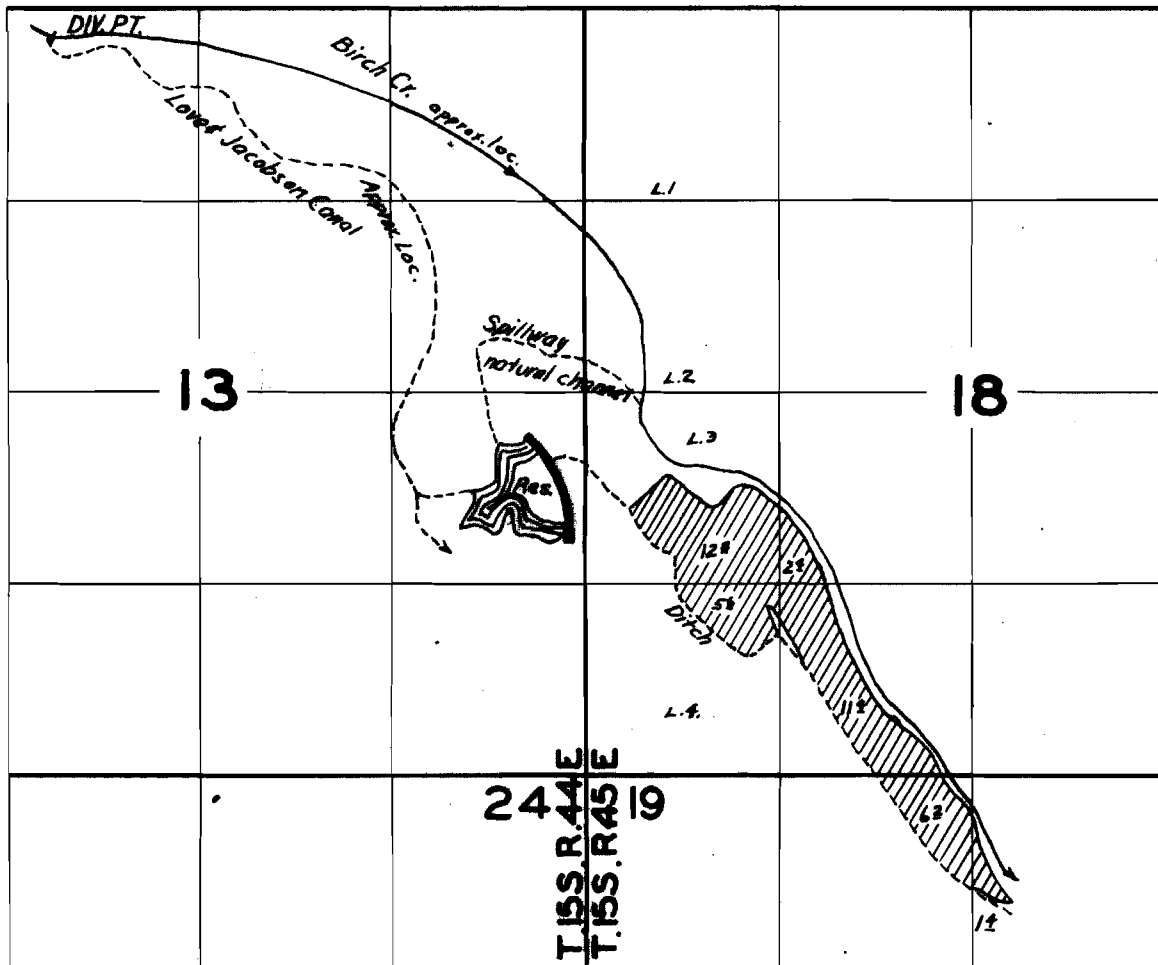

FINAL PROOF SURVEY

UNDER

R-21019

R-990

Application No. 21084 Permit No. 18967

IN NAME OF

DWIGHT LOCKETT

Surveyed July 7 1953, by T. Jones