


T.IN.R.3 W.W.M.

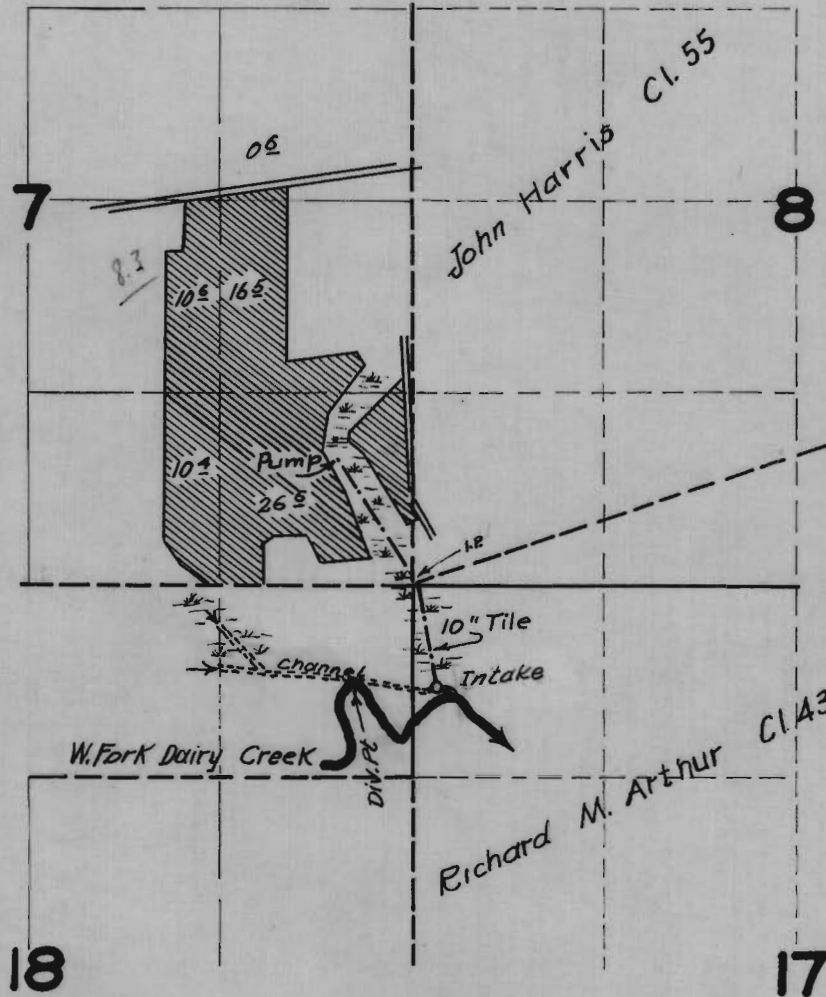

FINAL PROOF SURVEY

UNDER

Application No. 24189 Permit No. 19020

IN NAME OF

LOUIS M. SPIERING

Surveyed June 9, 1952, by H. L. COFFMAN