


T. . R. . W.M.

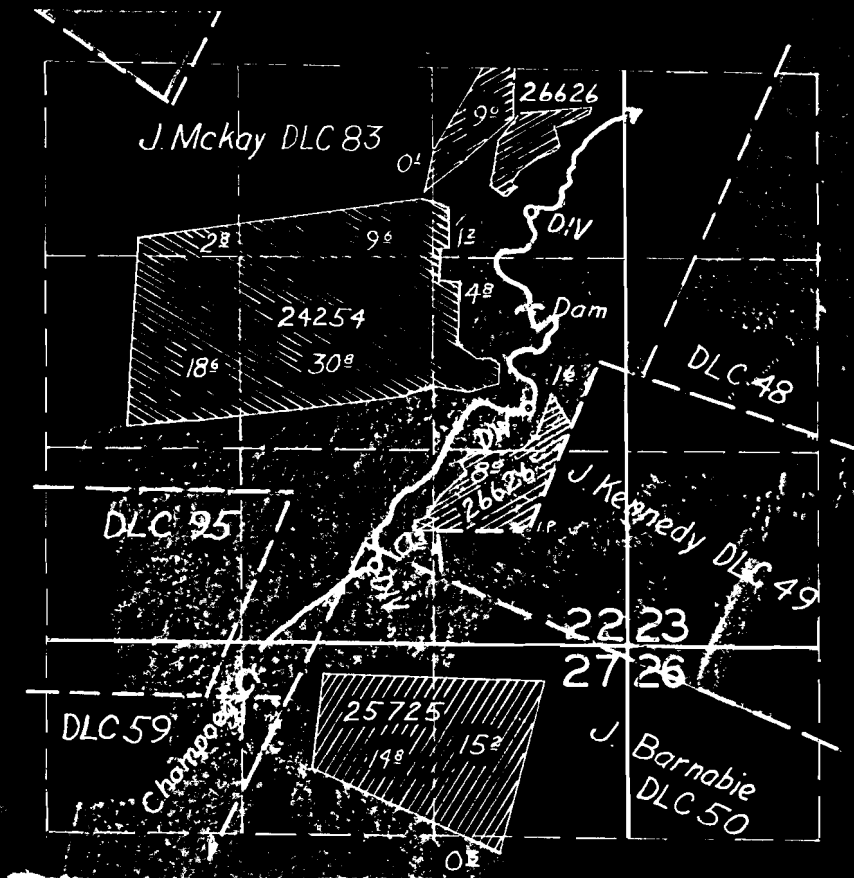

**FINAL PROOF SURVEY**  
UNDER

Application No. . . . . Permit No. . . . .  
IN NAME OF

Surveyed . . . . . 19 . . . . . by . . . . .