


T.22S.R.3W.W.M.

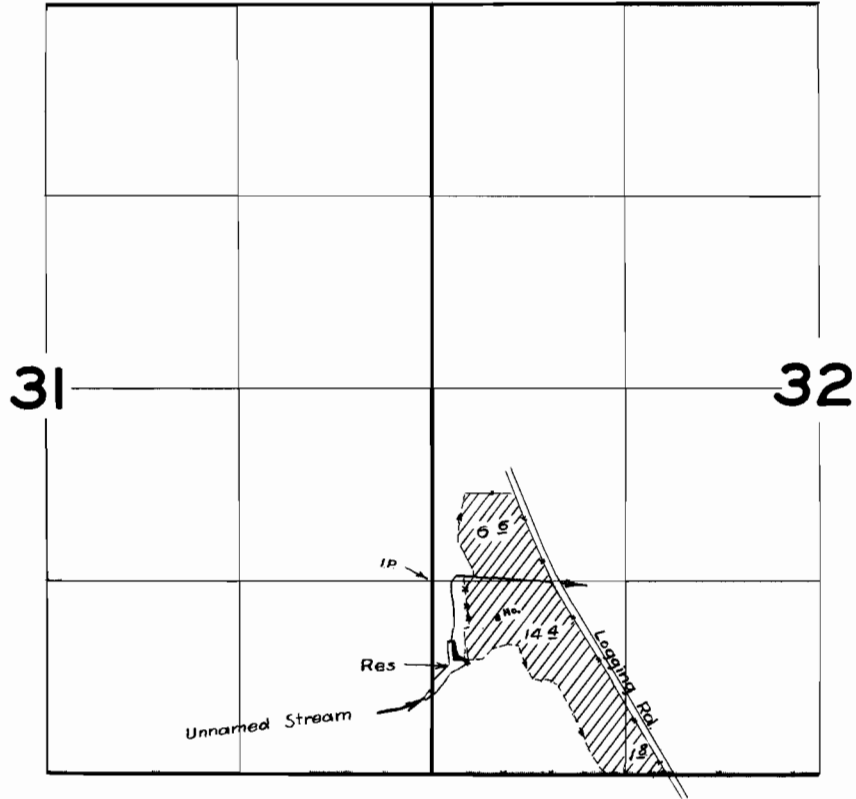

FINAL PROOF SURVEY

UNDER

R-25055

R-1093

Application No. 25056 Permit No. 19946...

IN NAME OF

Lee E. Bechtold

Surveyed April 23 1957, by M. Besh