


T.25S. R. 6W.W. M.

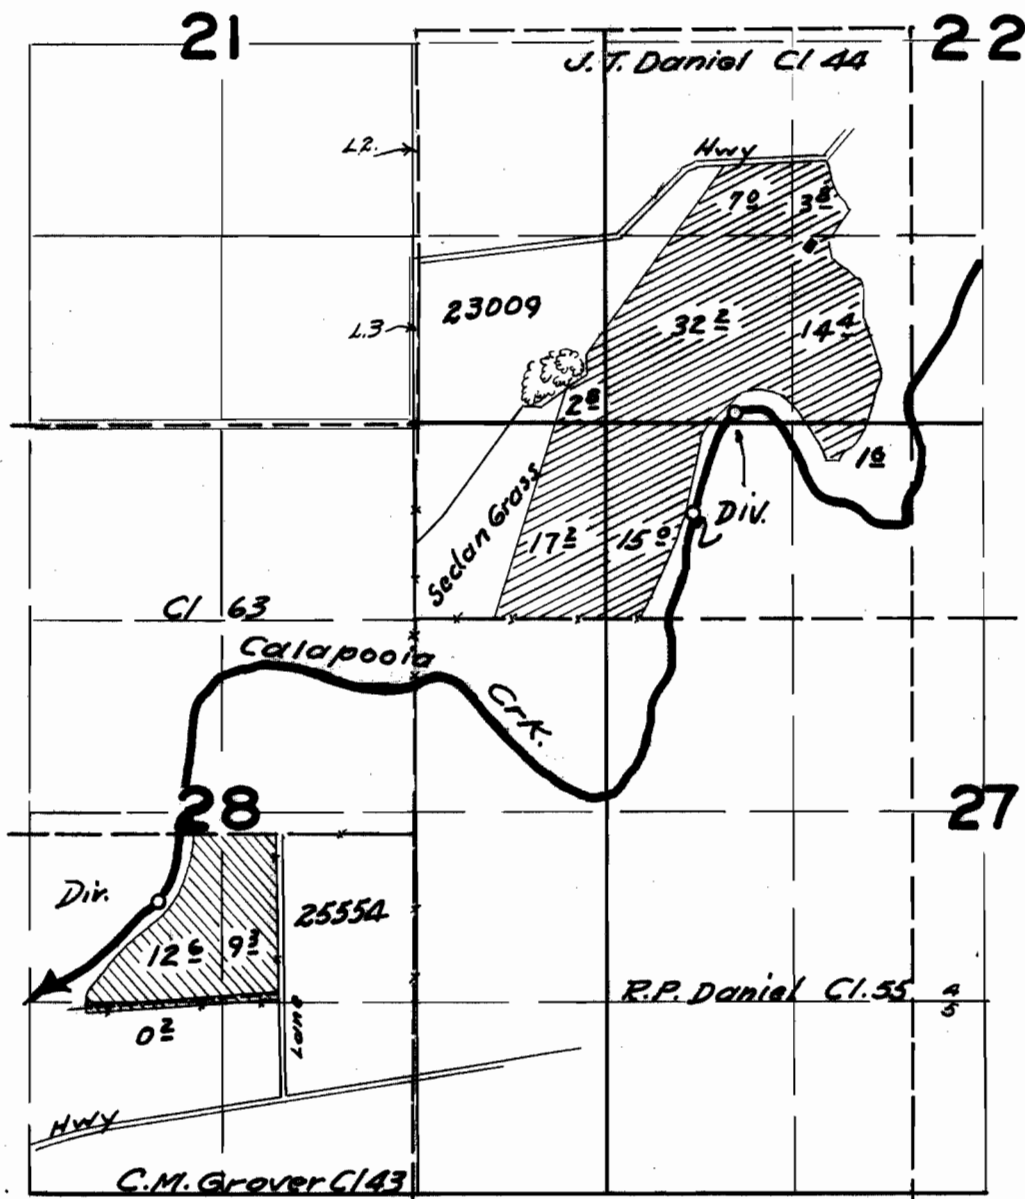

FINAL PROOF SURVEY

UNDER

Application No. 23009 25554 Permit No. 18106 20066

IN NAME OF
Harold Grouch

C. L. Richardson

Surveyed July 25 1954, by H. L. Coffman