


T.17S.R.9W.WM

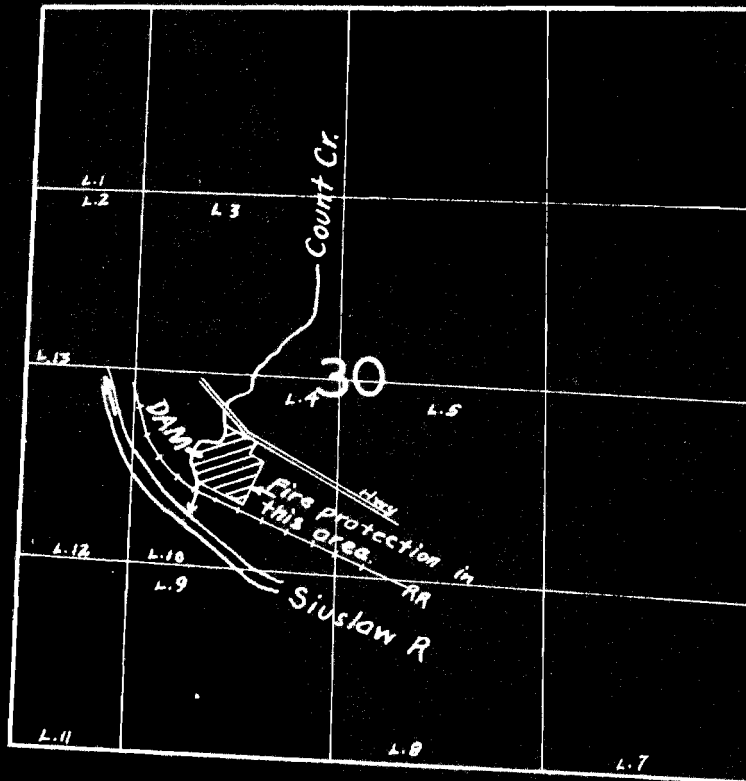

**FINAL PROOF SURVEY**

UNDER

R-25984

R-1170

Application No. 25985 Permit No. 20361

IN NAME OF

*Robert E. Haskins*

Surveyed Aug. 10, 1954, by *H.L. Caffman*