


T.35S.R.11W.W.M.

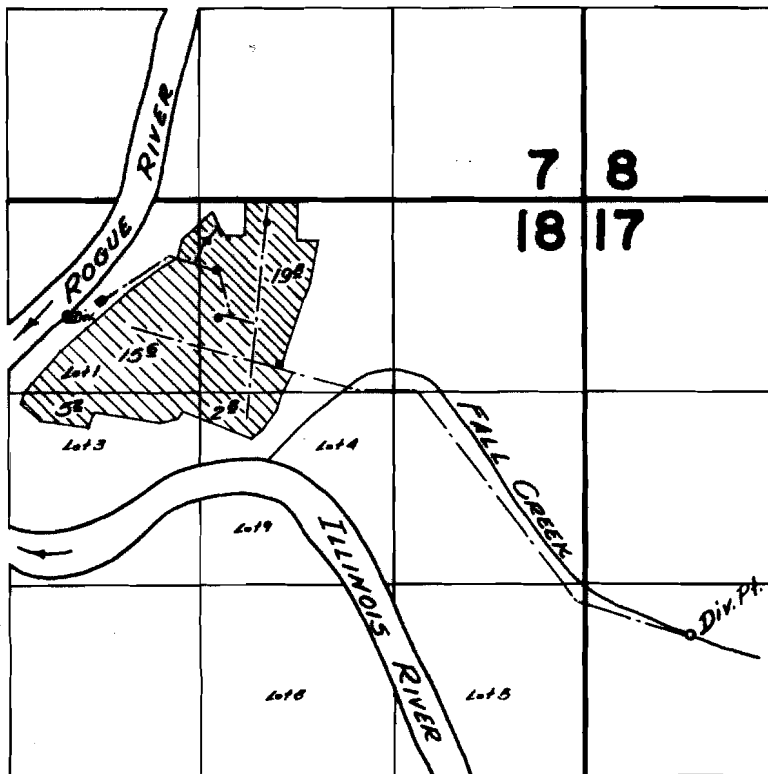

- Houses
- Cabins
- Stock Troughs
- Pipelines

FINAL PROOF SURVEY

UNDER

Application No. 32317 Permit No. 25527
26720 .. 20911

IN NAME OF

..... D. D. LUCAS

Surveyed Aug. 26th 1961, by W. B. Baile