


T.35 S. R. 11 & 12 W.W.M.

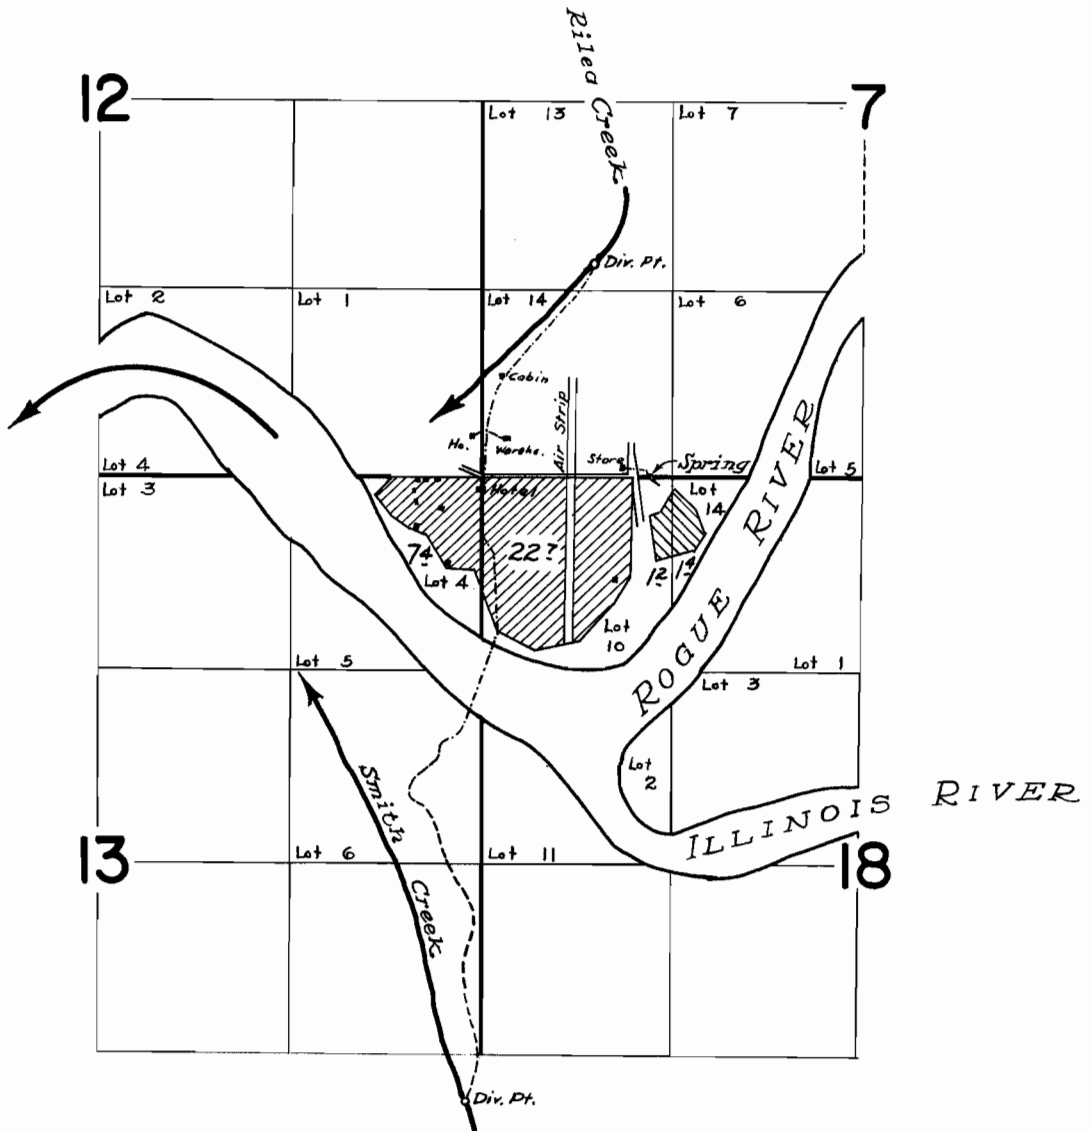

FINAL PROOF SURVEY
UNDER

25057 19733
28698 22596

Application No. 30154 Permit No. 23564
IN NAME OF

LARRY & HELEN A. LUCAS

Surveyed August 30 1961, by C. O. Bartels