


# T.35 S.R.1 W.W.M.

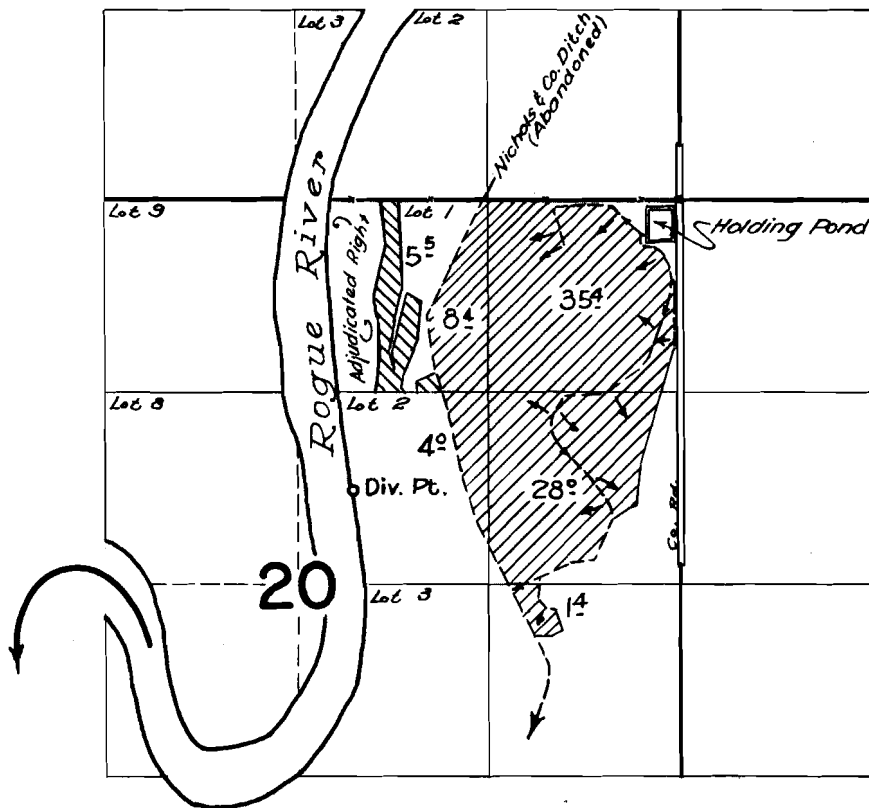

 32439

 32849

## FINAL PROOF SURVEY UNDER

Application No. **32439**... Permit No. **25606**  
~~32849~~... ~~25948~~...  
 IN NAME OF

**GEORGE H. JESS**

Surveyed May 22:23 1963, by *[Signature]*