


TOWNSHIP 12 S., RANGE 26 E., W.M.

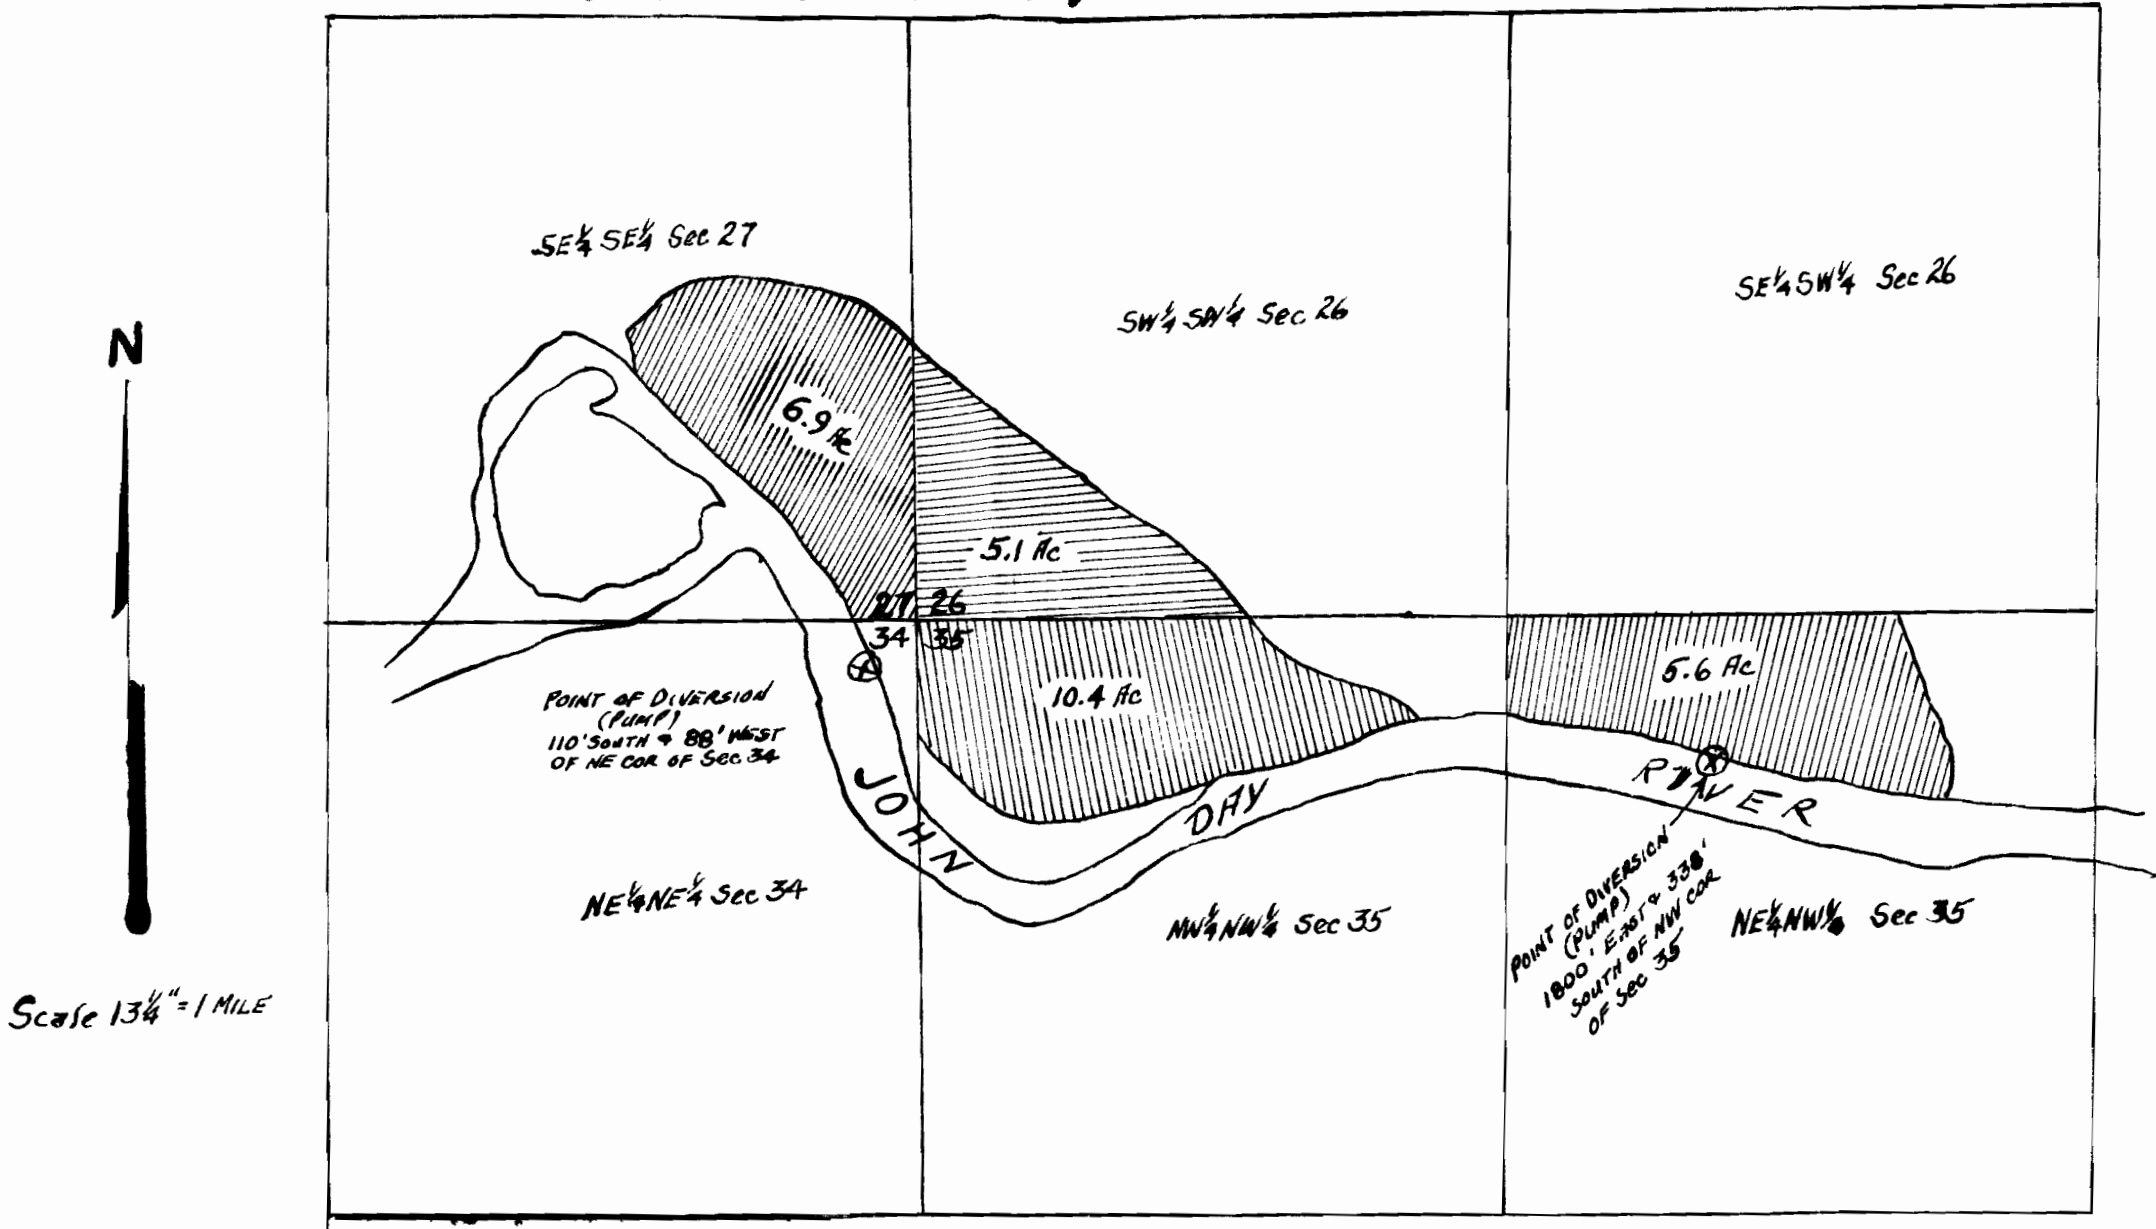

Application No. 37743
Permit No. 28131