


T. 24 S. R. 27 E. W. M.

T. 25 S. R. 28 E. W. M.

T. 25 S. R. 29 E. W. M.

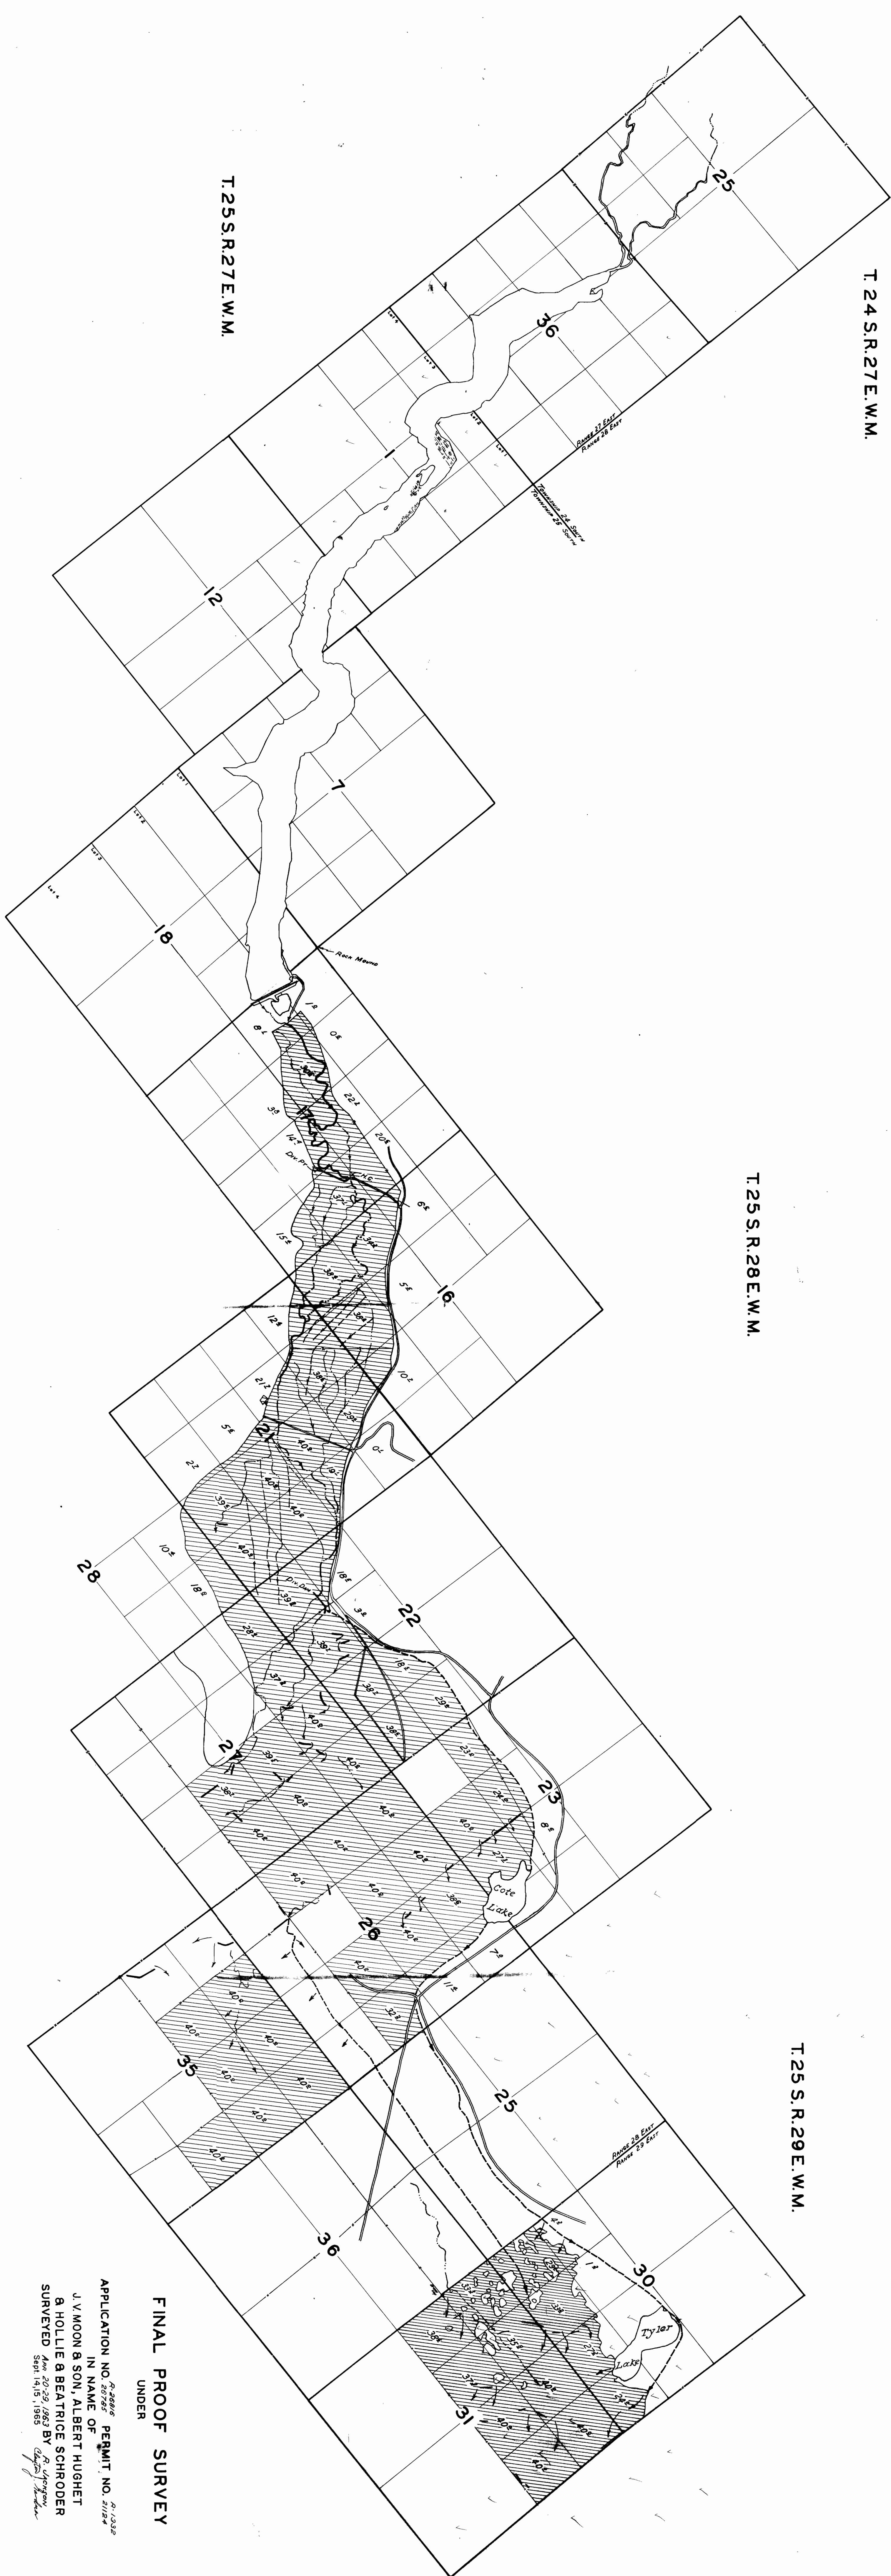

FINAL PROOF SURVEY
UNDER

 IN NAME OF
 J. V. MOON & SON, ALBERT HUGHET
 & HOLLIE & BEATRICE SCHRODER
 SURVEYED *Apr 20-29, 1963* BY *R. V. Morgan*
Sept. 14, 15, 1965