



T.38S., R.4W., W.M.

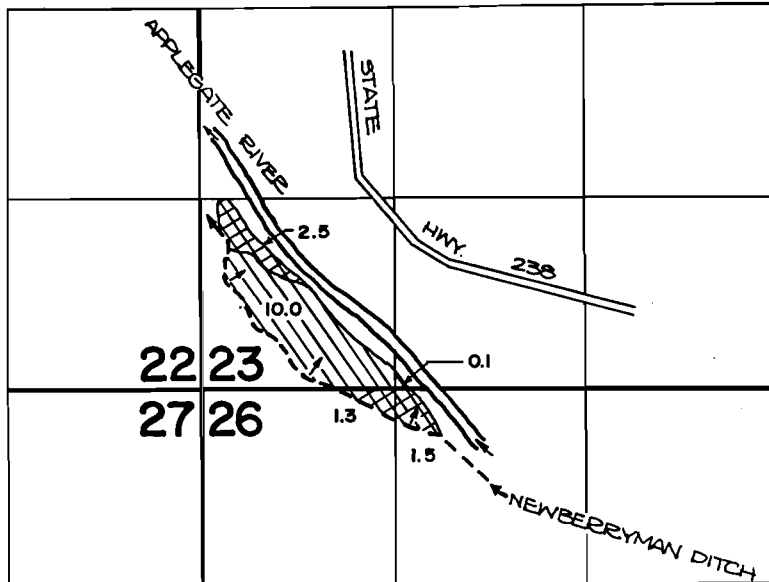

PERMIT 45962



PERMIT 41702

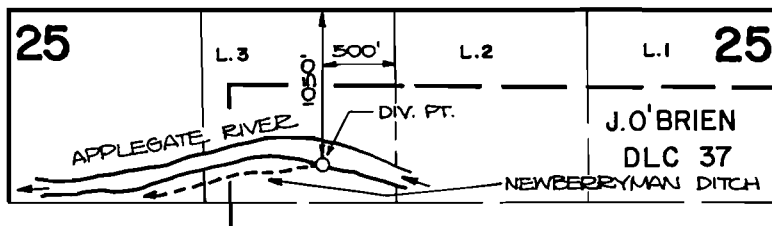

FINAL PROOF SURVEY UNDER

62133 45962
Application No. 55669 Permit No. 41702....
IN NAME OF

HENRY...W...AND/OR...JEANETTE...R...HEAD

Surveyed April...6... 1982, by Bruce...R...Sund..