

THIS MAP PREPARED BY:


Bob Man

FROM INFORMATION FURNISHED BY
THE APPLICANT.

T.13S., R.28E., W.M.

Application No. 55875

Permit No. 41911

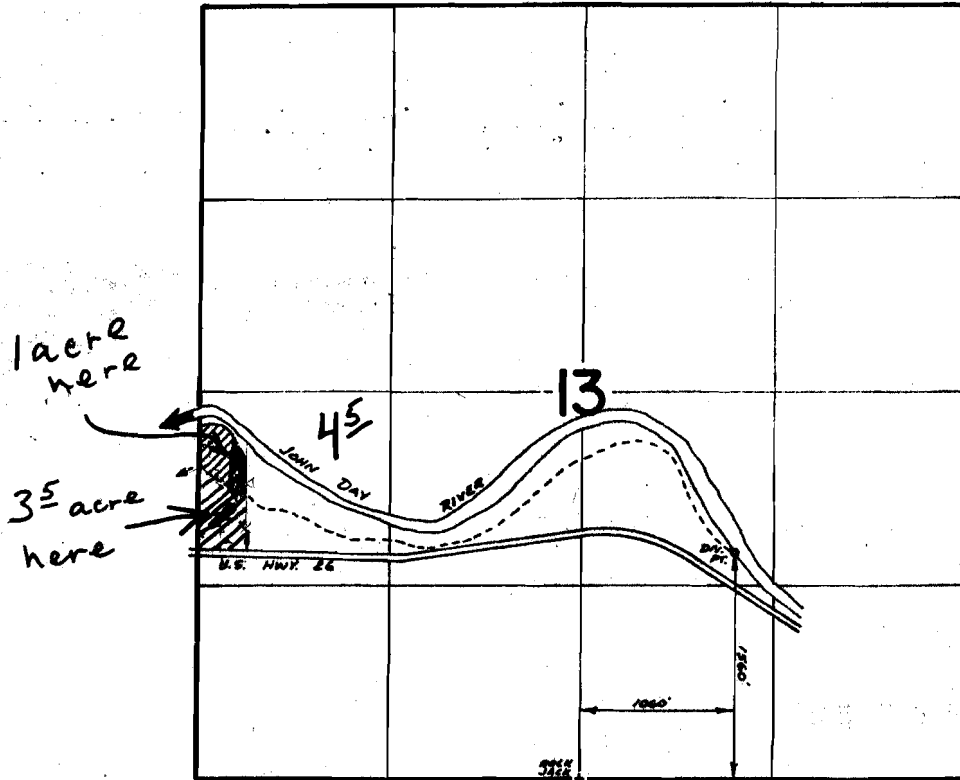

RECEIVED
MAY 10 1977
WATER RESOURCES DEPT
SALEM, OREGON

Application Map

~~FINAL PROOF SURVEY~~

UNDER

For Eugene and Mandy Lippert

Application No. ~~41911~~ Permit No. ~~55875~~

IN NAME OF

EUGENE AND MANDY LIPPERT

Surveyed June 21, 1975, by D. Norby