


Application No. 57997 RECEIVED  
 Permit No. 43786

APR 30 1986

WATER RESOURCES DEPT  
 SALEM, OREGON

T. 38 S. R. 4 W. W. M.

*Area in question*

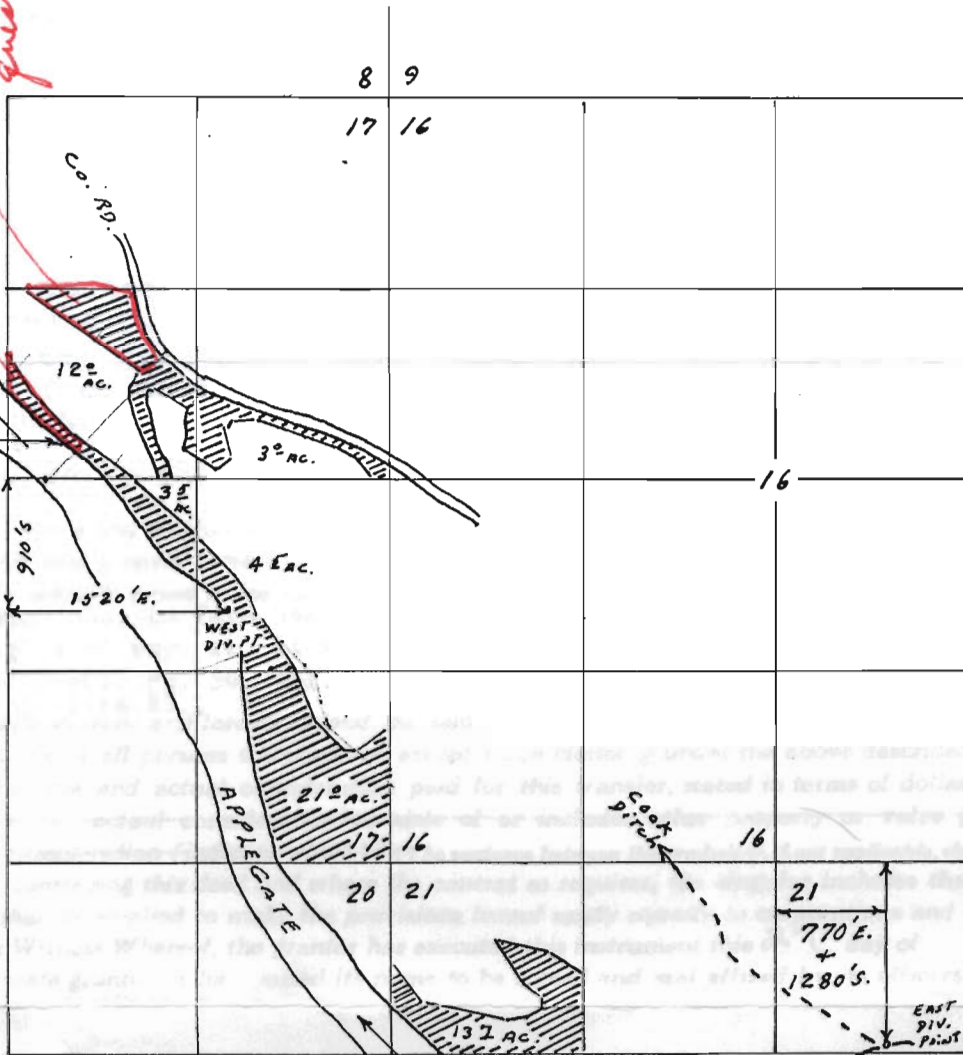

DIV. PT. #3 IS  
 LOCATED 2400' S.  
 AND 380' E. FROM  
 THE N. 1/4 COR.  
 OF SEC. 17

MAP TO ACCOMPANY APPLICATION OF  
 PATRICK J. CUNNINGHAM FOR IRRIGATION

RECEIVED


OCT 16 1978

WATER RESOURCES DEPT.  
 SALEM, OREGON

SCALE 4" = 1 MILE

THIS MAP PREPARED BY:

*Patrick J. Cunningham*  
 FROM INFORMATION FURNISHED BY  
 THE APPLICANT.

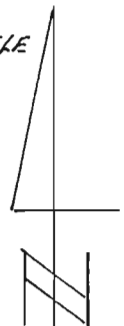

10-11-78