


R17E

R18E

O = WATER SOURCE
 ~ ~ = WATER USE
 #50889

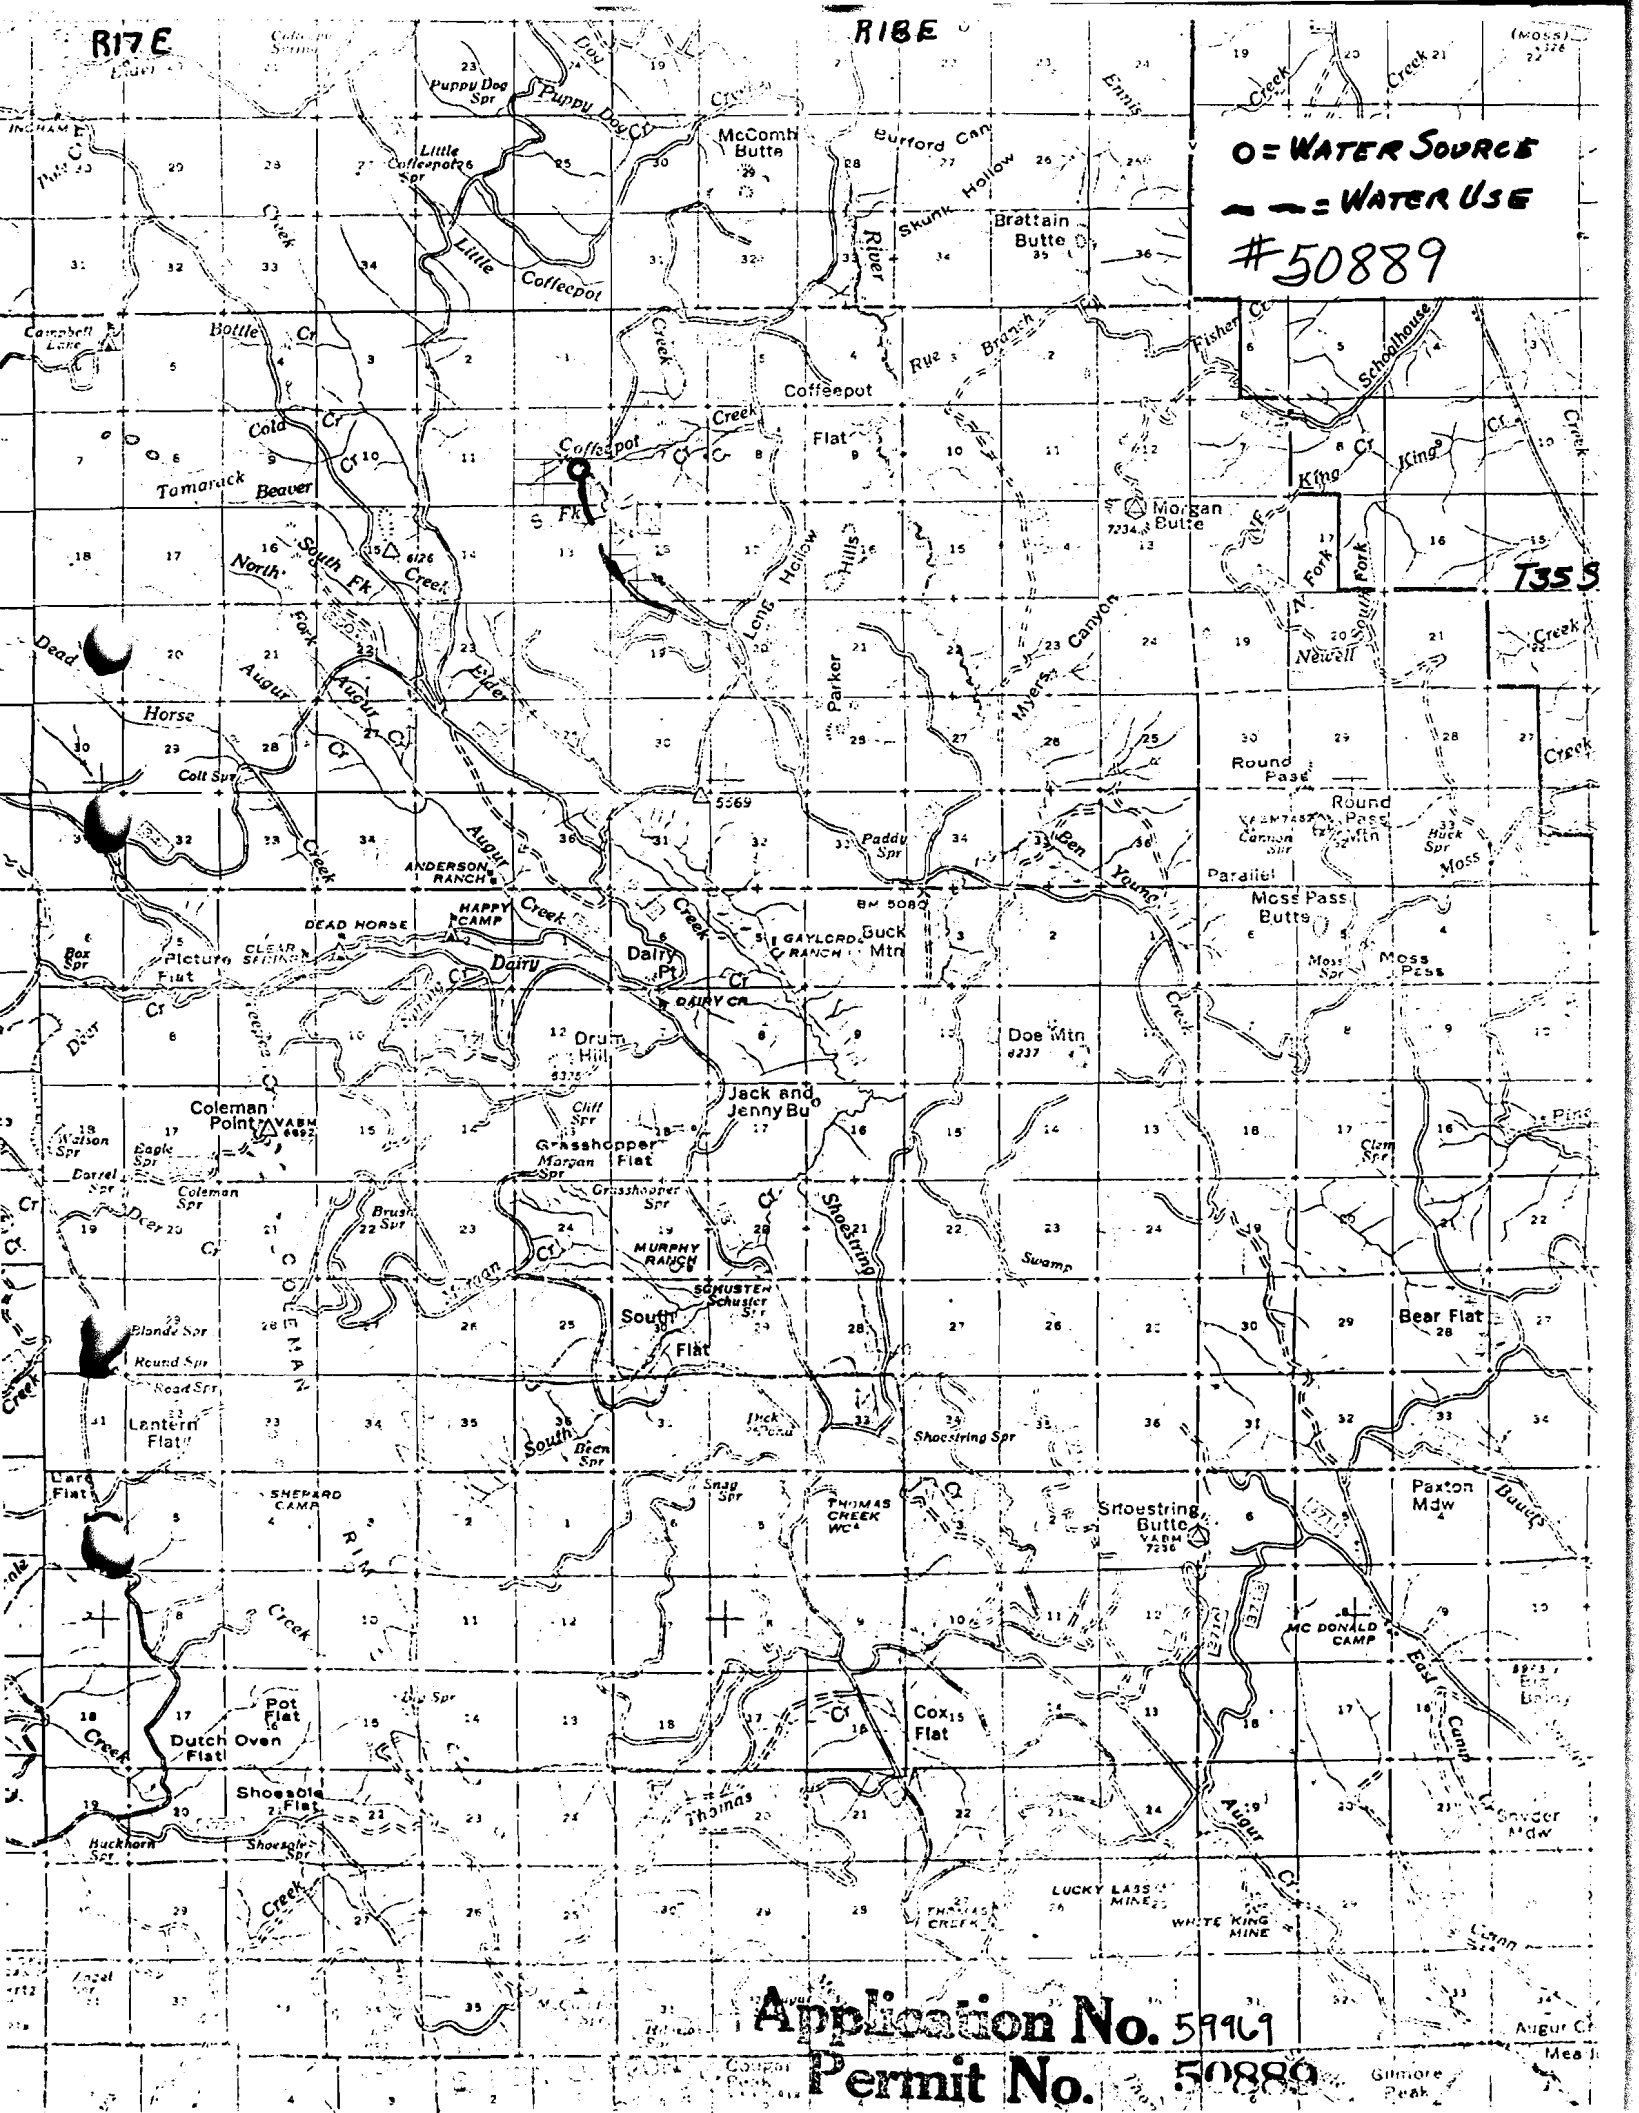

T35S

Application No. 59969

Permit No. 50889

Gilmore Peak