


# T. 27 S., R. 6 W., W.M.

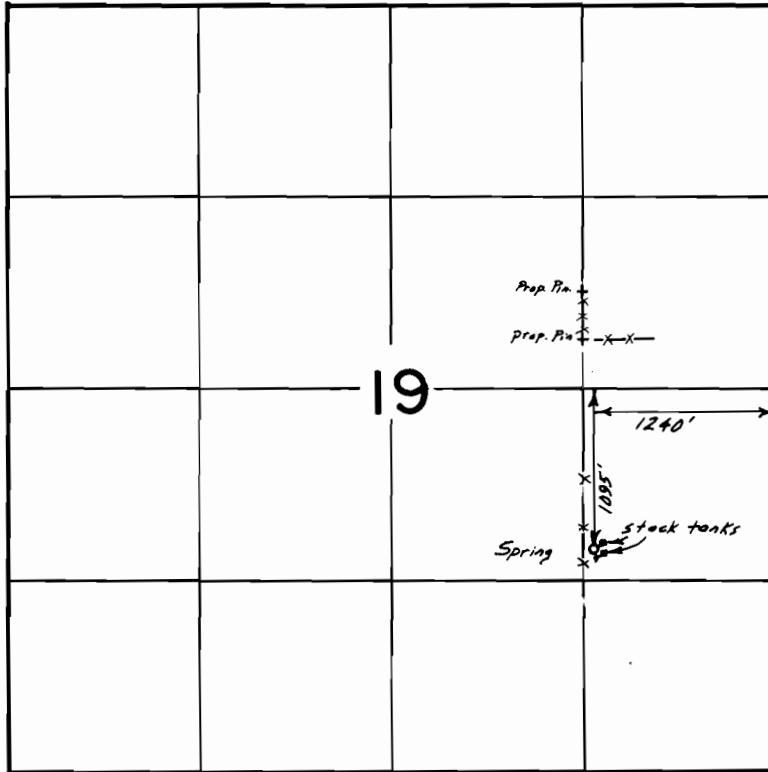

Scale 1" = 1320'

## FINAL PROOF SURVEY UNDER

Application No. 60960 Permit No. 45406...  
IN NAME OF

...ALICE M. LOOKER BOTHMAN...

Surveyed Aug. 1, 1990, by B.S. James.....