


AUG 04 1999

Scale: 1" = 400 ft.

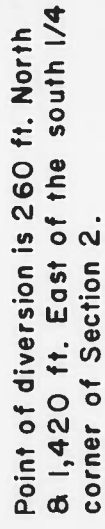

Transfer No. 7694

For: Samuel James Noonkester &

210 E. Lee Street

By: Shaner Engineering, Inc.

Roseburg, Oregon 97470

August 2, 1999

STATE OF OREGON
COUNTY OF DOUGLAS
CERTIFICATE OF WATER RIGHT

THIS CERTIFICATE ISSUED TO

TERRY STRECKER
SAMUEL NOONKESTER
3463 S MYRTLE RD
MYRTLE CREEK OR 97457

confirms the right to use the waters of COW CREEK, a tributary to SOUTH UMPQUA RIVER for IRRIGATION of 5.3 ACRES.

This right was confirmed by decree of the Circuit Court of the State of Oregon for Douglas County. The decree is of record at Salem, in the Order Record of the Water Resources Director in Volume 11, at Page 1. The date of priority is OCTOBER 9, 1905.

The amount of water to which this right is entitled is limited to an amount actually used beneficially, and shall not exceed 0.076 CUBIC FOOT PER SECOND, or its equivalent in case of rotation, measured at the point of diversion.

The point of diversion is located as follows:

Twp	Rng	Mer	Sec	Q-Q	Measured Distances
32 S	3 W	WM	2	SE SE	260 FEET NORTH AND 1420 FT EAST FROM S1/4 CORNER, SECTION 2

The amount of water used for irrigation, together with the amount secured under any other right existing for the same lands, is limited to the rate of one cubic foot of water per second for each 70 acres of land irrigated during the irrigation season.

A description of the place of use is as follows:

Twp	Rng	Mer	Sec	Q-Q	Acres
32 S	3 W	WM	2	SW SE	3.8
32 S	3 W	WM	2	SE SE	1.5

The right to the use of the water for the above purpose is restricted to beneficial use on the lands or place of use described, and is subject to all other conditions and limitations contained in said decree.

NOTICE OF RIGHT TO PETITION FOR RECONSIDERATION OR JUDICIAL REVIEW

This is an order in other than a contested case. This order is subject to judicial review under ORS 183.482. Any petition for judicial review must be filed within the 60-day time period specified by ORS 183.482. Pursuant to ORS 183.482, ORS 536.075 and OAR 137-003-0675, you may petition for judicial review and petition the Director for reconsideration of this order. A petition for reconsideration may be granted or denied by the Director, and if no action is taken within 60 days following the date the petition was filed, the petition shall be deemed denied.

The quantity of water diverted at the new point of diversion, together with that diverted at the old point of diversion, shall not exceed the quantity of water lawfully available at the original point of diversion described as follows:

Original POD Location
JORDEN-WILLIAMS DITCH


When required by the Department, the water user shall install and maintain a headgate, an in-line flow meter, weir, or other suitable device for measuring and recording the quantity of water diverted. The type and plans of the headgate and measuring device must be approved by the Department prior to beginning construction and shall be installed under the general supervision of the Department.

Water shall be acquired from the same surface water source as the original point of diversion.

The water user shall maintain a fish screen or by-pass device.

This certificate is issued to confirm a change in POINT OF DIVERSION approved by an order of the Water Resources Director entered June 12, 1997, at Special Order Volume 51, Page 541, approving Transfer Application 7694, and together with Certificate 74520, supercedes Certificate 9667 State Record of Water Right Certificates.

Issued SEP 19 2014

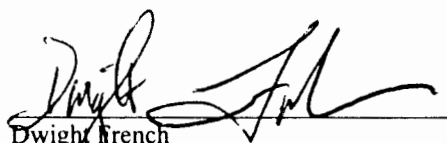

Dwight French
Water Right Services Division Administrator, for
Director
Oregon Water Resources Department