

STATE OF OREGON  
COUNTY OF WASHINGTON  
CERTIFICATE OF WATER RIGHT

DONALD C. & JEAN JESSE  
RT 2 BOX 24  
HILLSBORO OR

confirms the right to use the waters of the TUALATIN RIVER, tributary of the WILLAMETTE RIVER, for SUPPLEMENTAL IRRIGATION OF 24.8 ACRES.

This right was perfected under Permit S-23242. The date of priority is SEPTEMBER 15, 1954. The amount of water to which this right is entitled is limited to an amount actually used beneficially, and shall not exceed 0.31 CUBIC FOOT PER SECOND or its equivalent in case of rotation, measured at the point of diversion.

The point of diversion is located as follows:

Twp	Rng	Mer	Sec	Q-Q
1 S	2 W	WM	7	SW SW

The amount of water used for irrigation under this right, together with the amount secured under any other right existing for the same lands, shall be limited to a ONE-EIGHTIETH of one cubic foot per second per acre, or its equivalent for each acre irrigated and shall be further limited to a diversion of not exceed 2.5 acre-feet per acre for each acre irrigated during the irrigation season of each year.

The right shall conform to such reasonable rotation system as may be ordered by the proper state officer.

A description of the place of use to which this right is appurtenant is as follows:

SUPPLEMENTAL IRRIGATION					
Twp	Rng	Mer	Sec	Q-Q	Acres
1 S	3 W	WM	12	SE SE	24.8

**NOTICE OF RIGHT TO PETITION FOR RECONSIDERATION OR JUDICIAL REVIEW**


This is an order in other than a contested case. This order is subject to judicial review under ORS 183.482. Any petition for judicial review must be filed within the 60-day time period specified by ORS 183.482. Pursuant to ORS 183.482, ORS 536.075 and OAR 137-003-0675, you may petition for judicial review and petition the Director for reconsideration of this order. A petition for reconsideration may be granted or denied by the Director, and if no action is taken within 60 days following the date the petition was filed, the petition shall be deemed denied.

This certificate is issued to describe the right modified by provisions of an order of the Water Resources Director, entered APR 04 2019, and recorded in Special Order Volume 112, Pages 872-883, approving the diminution of the right evidenced by Certificate 23123. This certificate supersedes Certificate 23123.

The issuance of this superseding certificate does not confirm the status of the water right in regard to the provisions of ORS 540.610 pertaining to forfeiture or abandonment.


The right to the use of the water for the above purpose is restricted to beneficial use on the lands or place of use described.

WITNESS the signature of the Water Resources Director, affixed April 4, 2019.

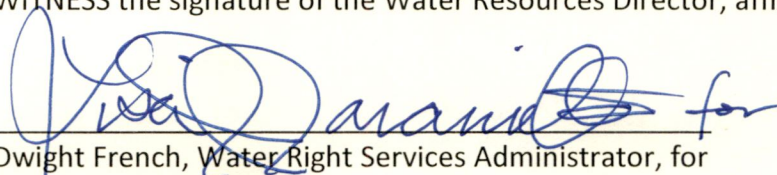  
\_\_\_\_\_  
Dwight French, Water Right Services Administrator, for  
Thomas M. Byler, Director

# T. 1S., R. 3W., W.M.

Section 16  
Washington County, Oregon

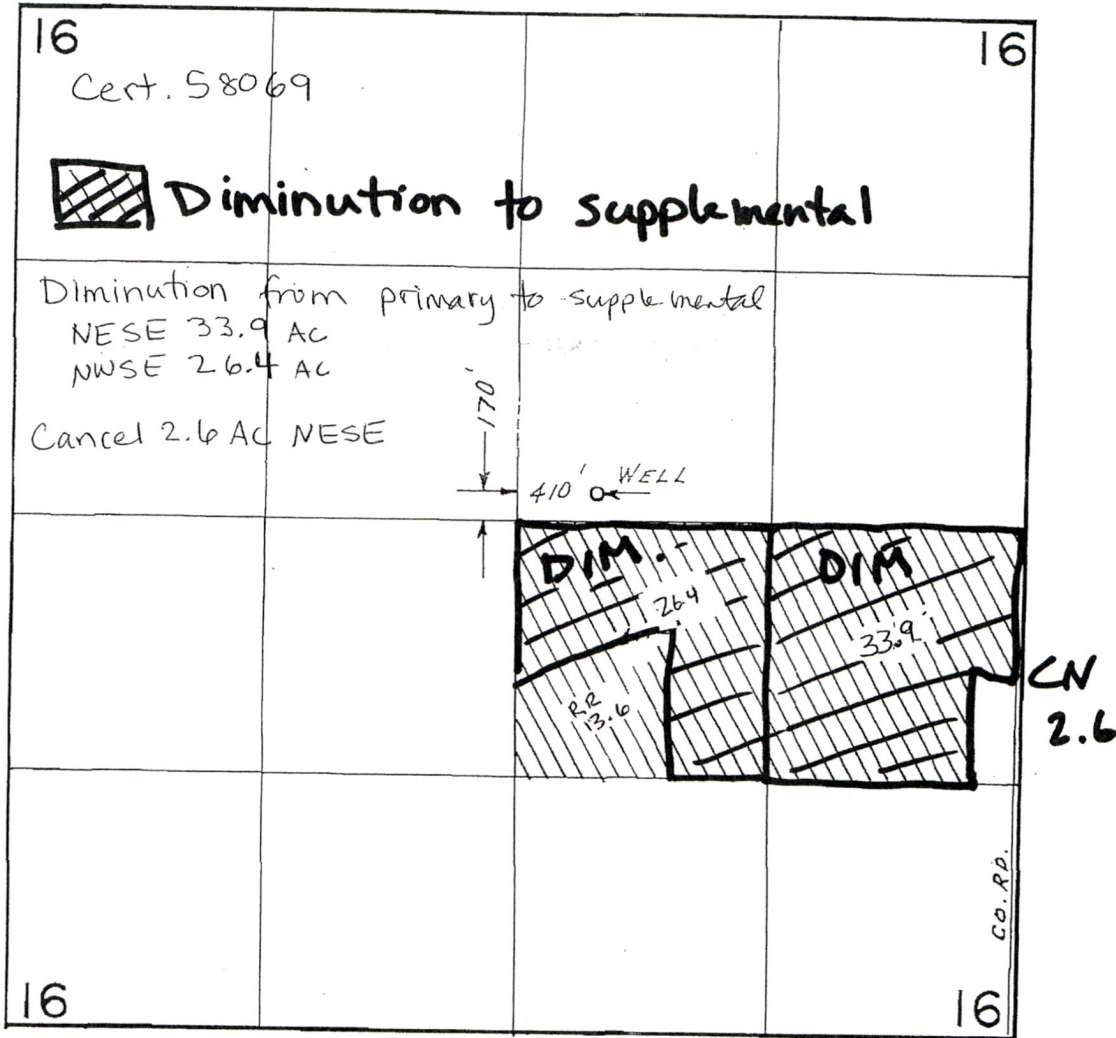

SCALE: 1" = 1320'

RECEIVED

JAN 11 2019

OWRD

T-10293