



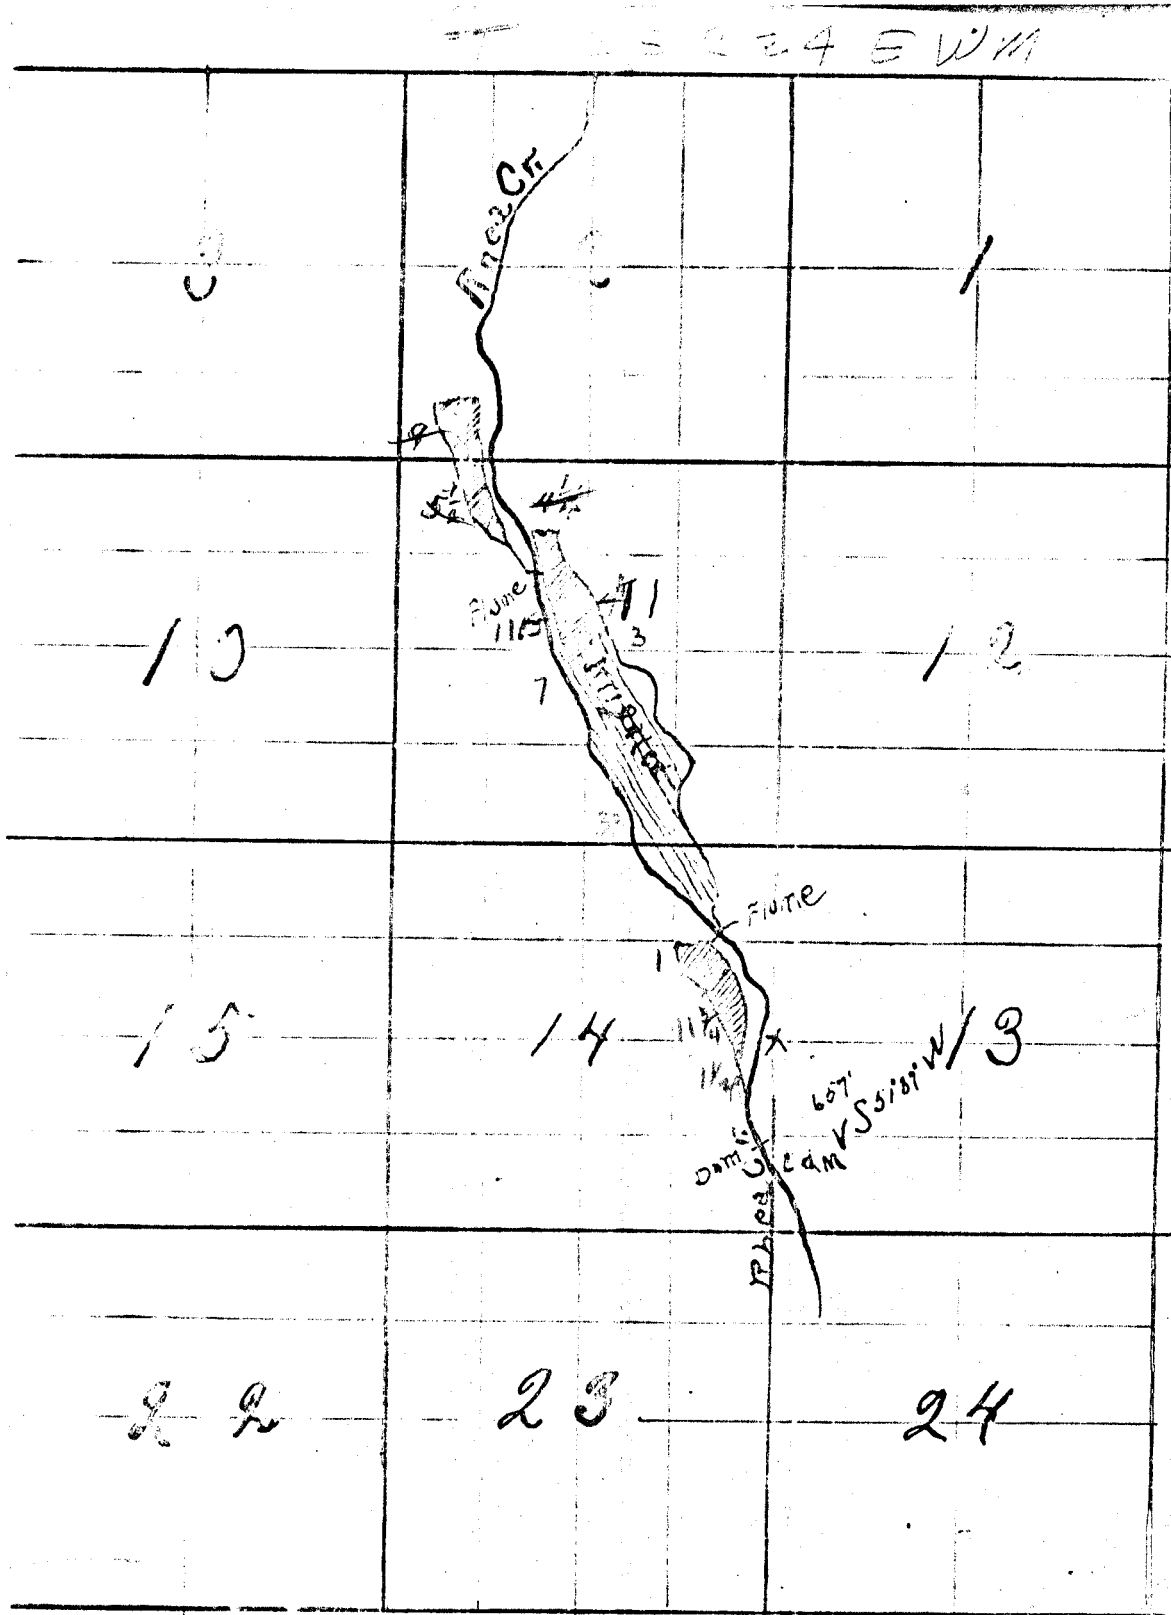

I, L. A. Hunt, of Heppner, Ore.,
do hereby certify that this map was made
from notes made during an actual survey made by
me Oct. 20, 1920, and that it correctly represents
the works described in the accompanying
application. Together with the streams and
other ditches in the immediate vicinity

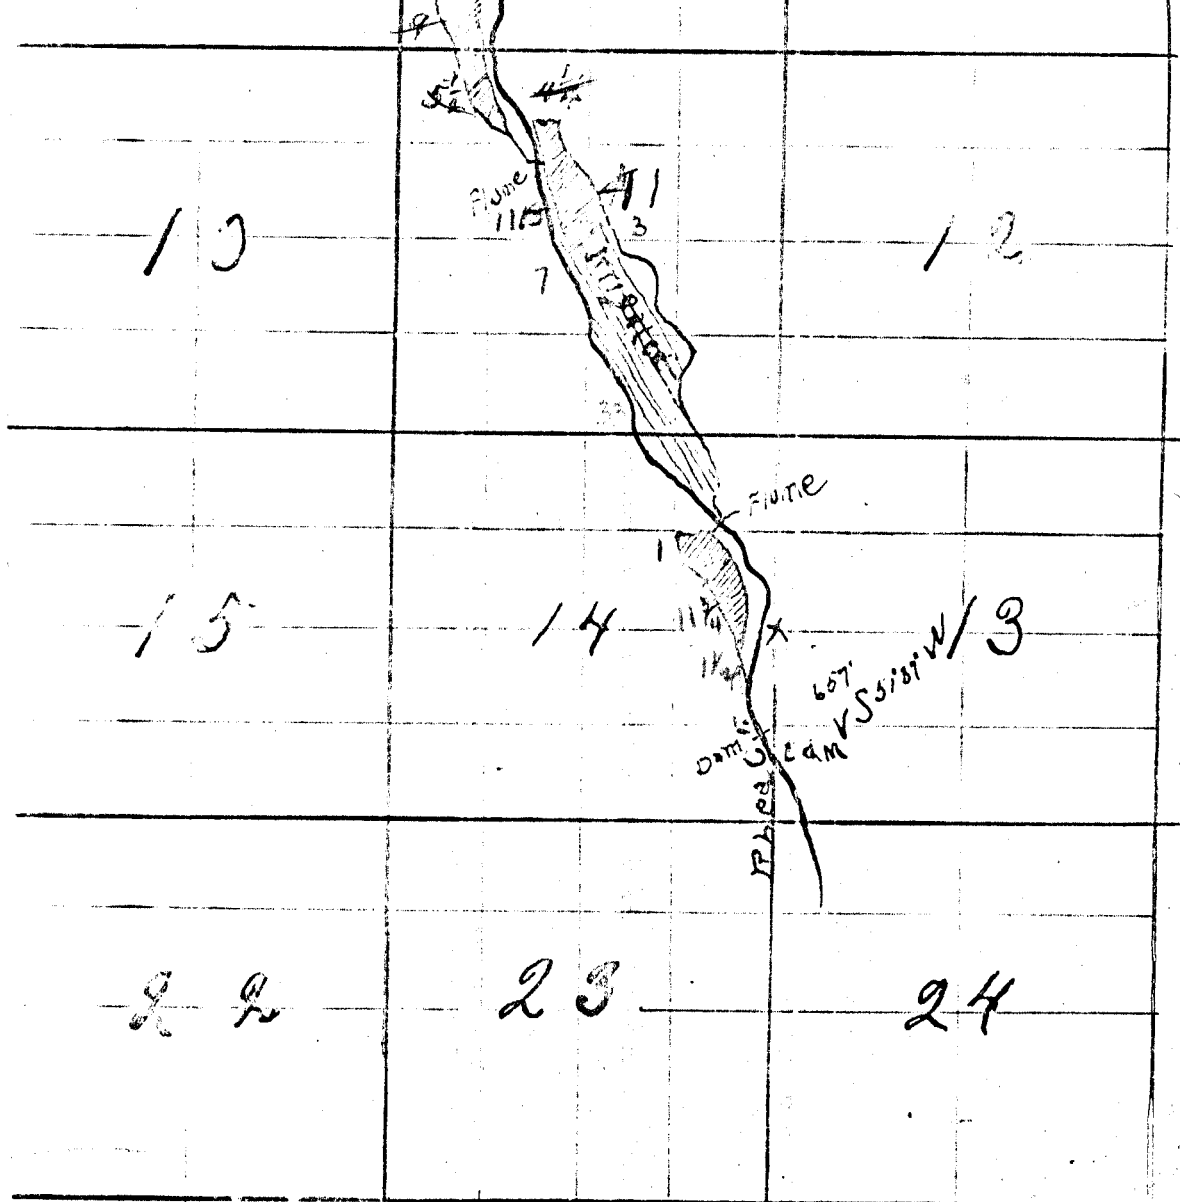

I, L. A. Hunt, of Heppner, Ore.,
do hereby certify that this map was made
from notes made during an actual survey made by
me Oct. 20, 1920, and that it correctly represents
the works described in the accompanying
application. Together with the streams and
other ditches in the immediate vicinity

L. A. Hunt
Surveyor

Application No. 8532

Permit No. 5575