


Sec.

Tr. 13 S.

R. 25 E.

Dis
NW Sec 2
148
24E

Per 8008
16018

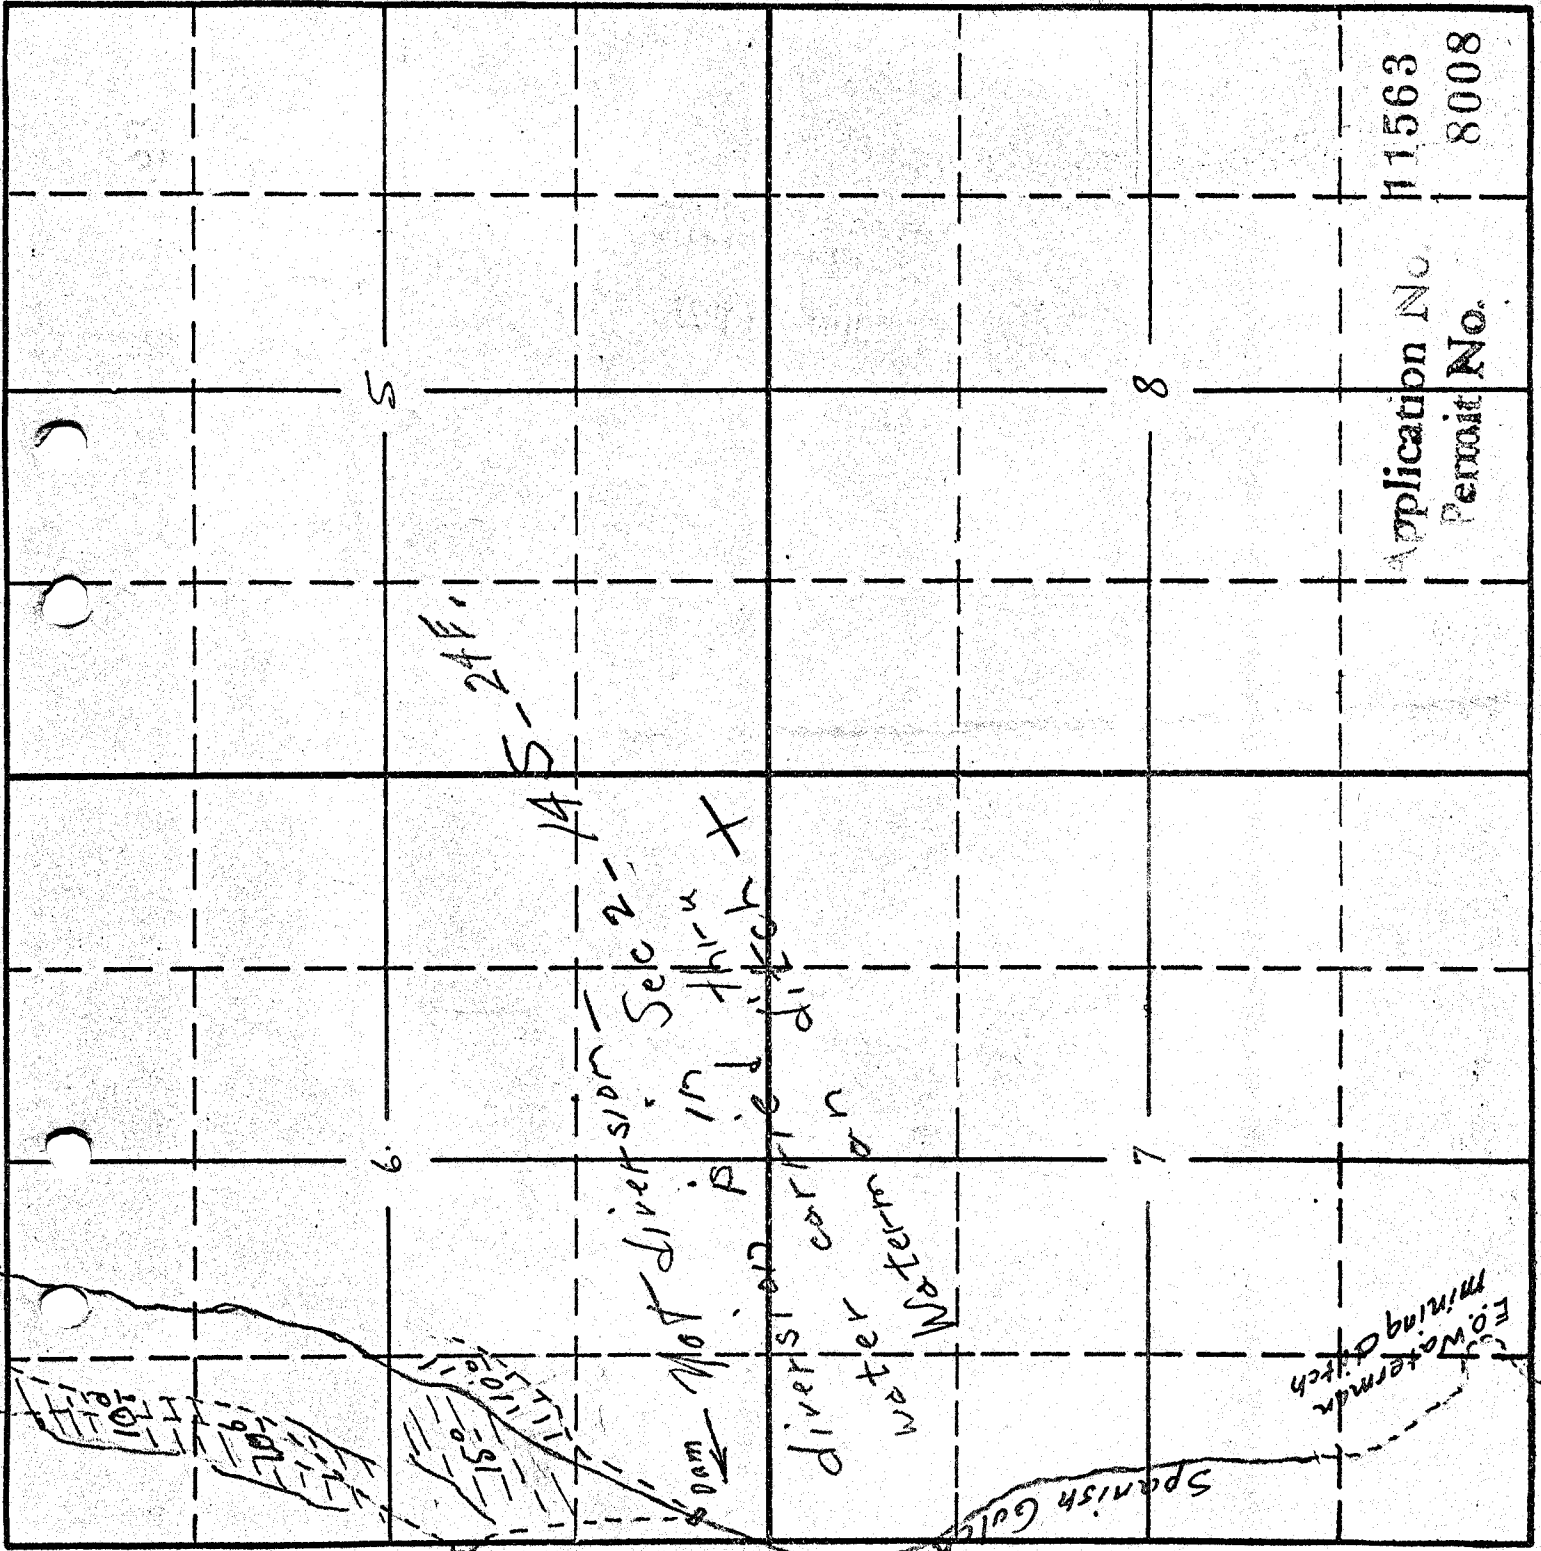

MAP
to accompany
Application
of
Paul H. Owens