


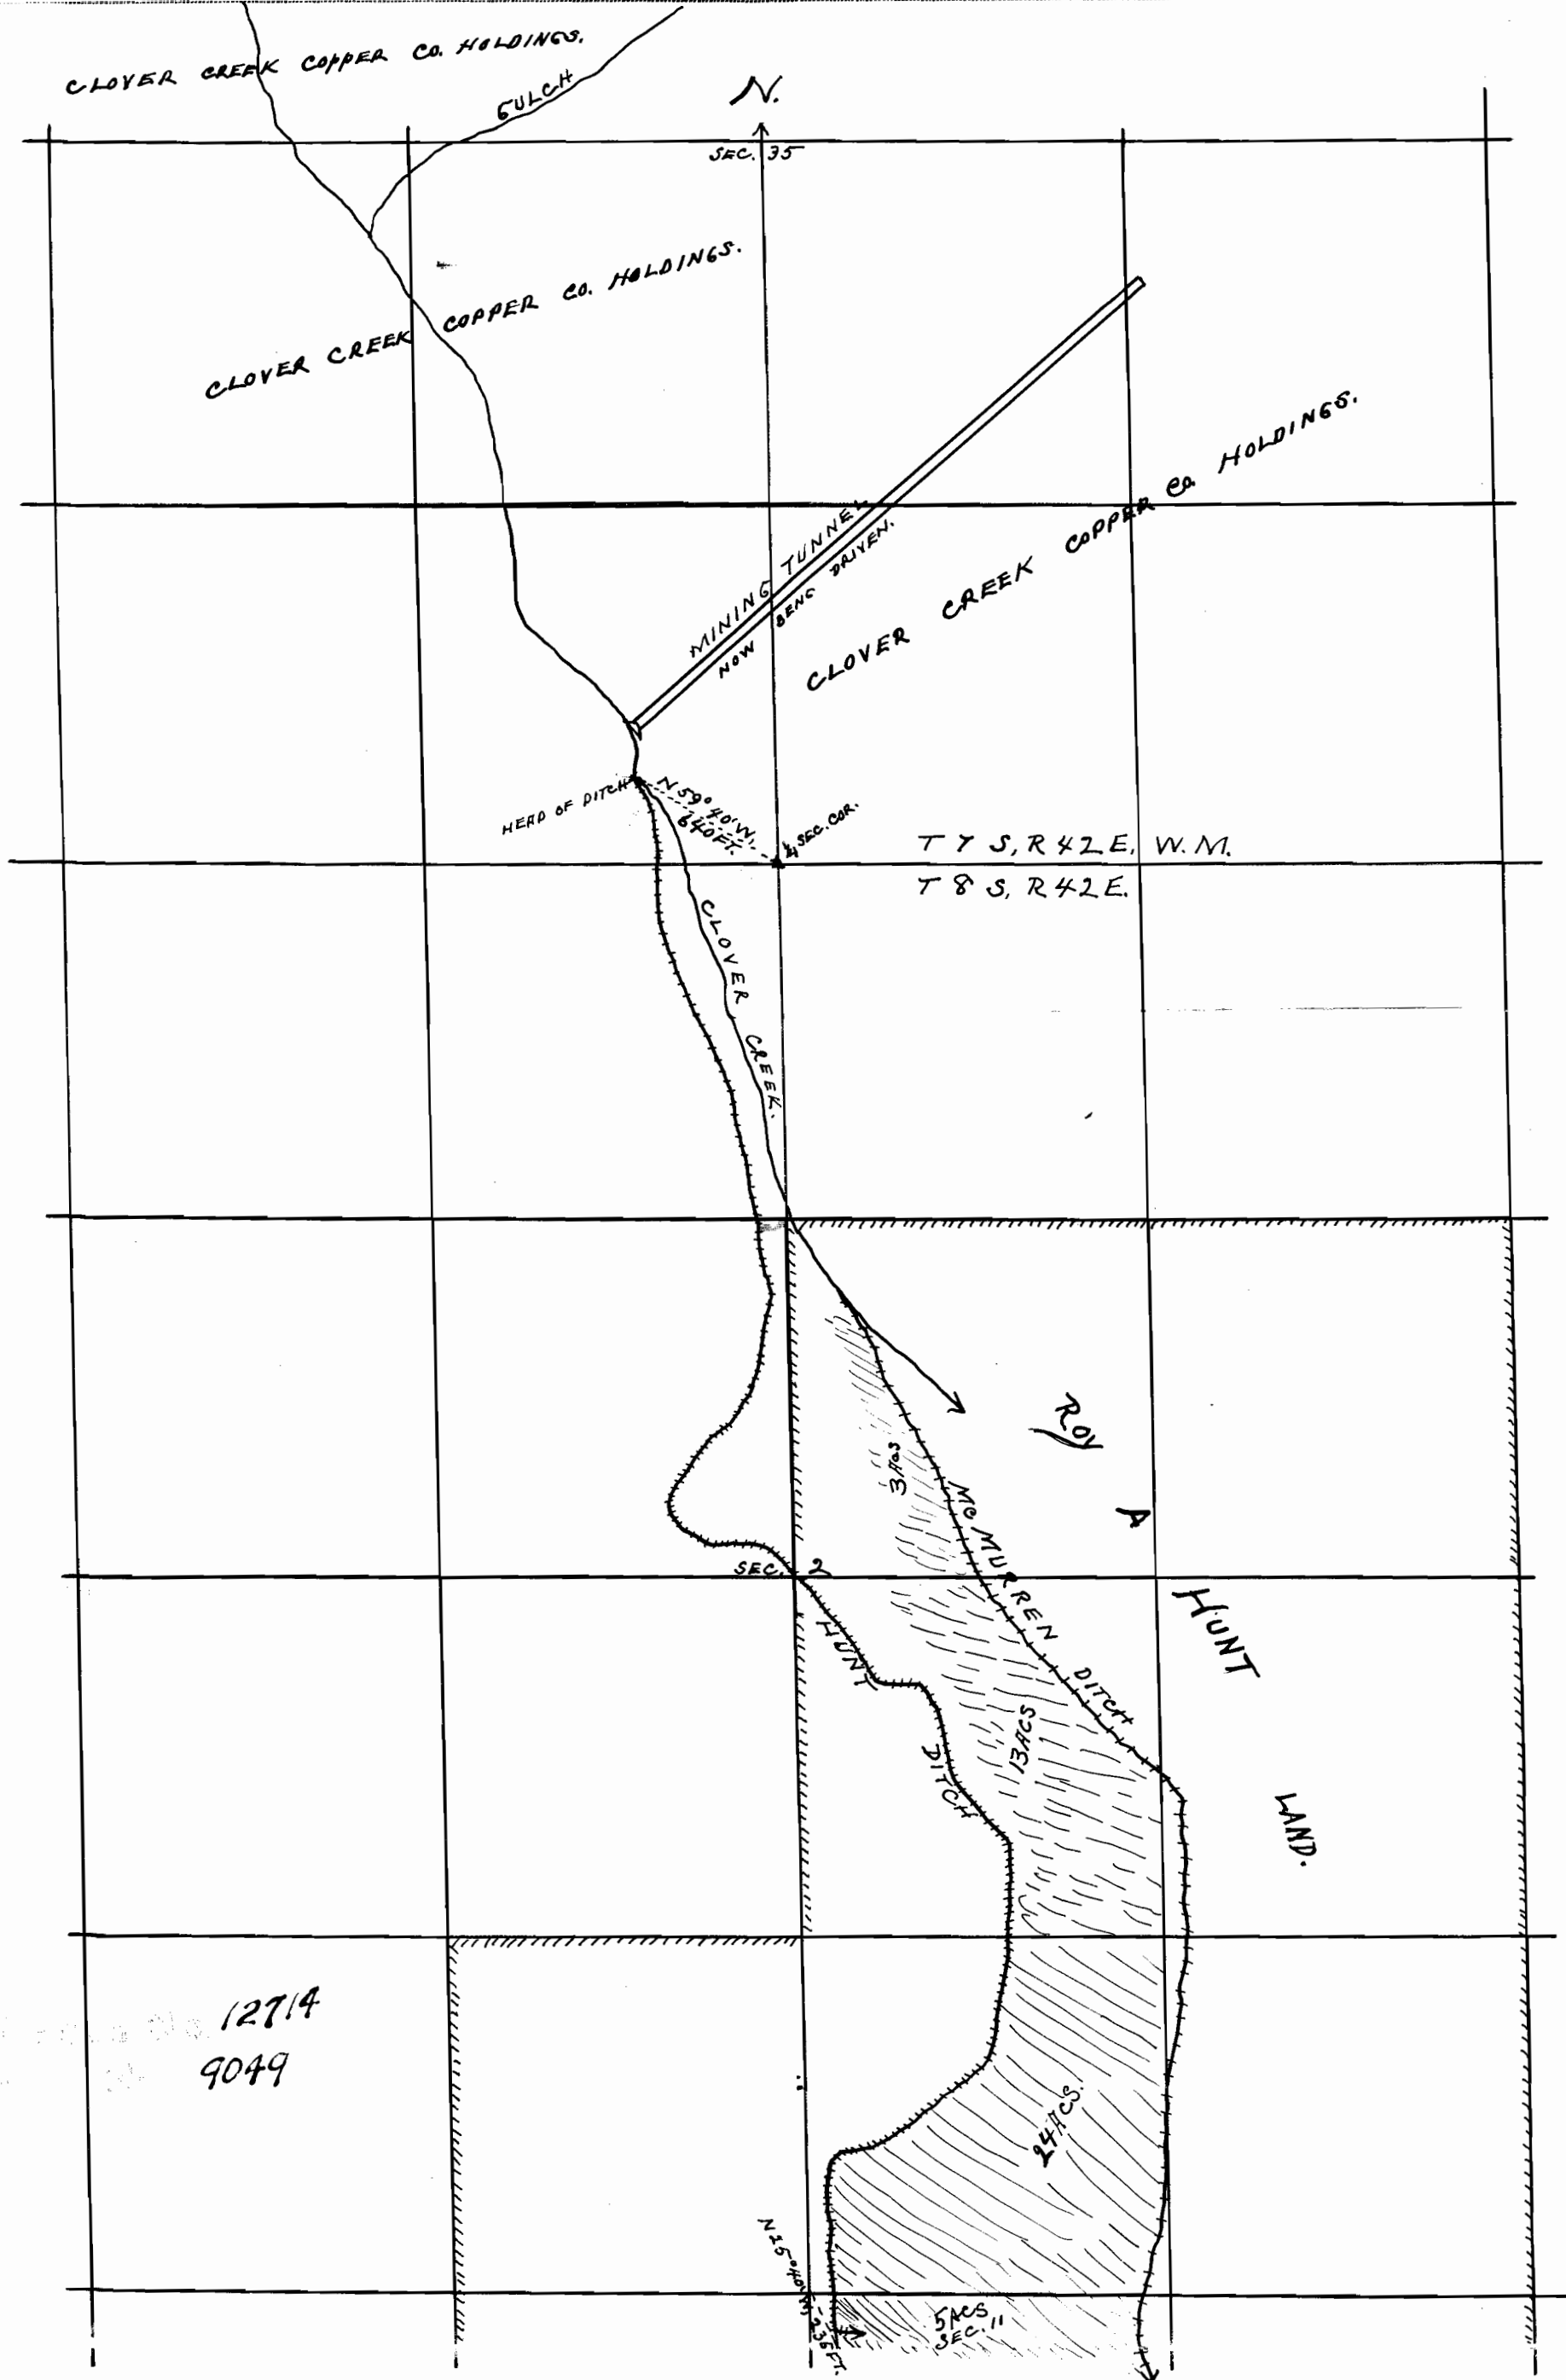

SKETCH

SHOWING

THE LOCATION OF LANDS IN SECS. 2+11, T 8 S, R 42 E, W. M, BAKER CO., ORE., TO BE IRRIGATED WITH FLOOD WATER FROM CLOVER CREEK AND WATER DEVELOPED IN MINING TUNNELS + SHAFTS DRIVEN FOR THE PURPOSE OF DEVELOPMENT OF THE MINERAL RESOURCES OF SEC. 35, T 7 S, R 42 E + ADJACENT LAND, FLOWING INTO CLOVER CREEK.

SCALE, ONE INCH = 600 FT

SURVEY MADE, MAY 1, 1929

Ira L. Hoffman
County Surveyor

CERTIFICATE.

I, IRA L. HOFFMAN OF BAKER, ORE. DO HERE BY CERTIFY THAT THIS SKETCH WAS MADE FROM NOTES TAKEN DURING AN ACTUAL SURVEY MADE BY ME ON MAY 1, 1929 AND THAT IT CORRECTLY REPRESENTS THE DATA SHOWN THEREON

Ira L. Hoffman
County Surveyor

REG. PROF. ENGINEER
NO. 90 OREGON NOV. 8, 1919.