


S² SW⁴ NW⁴ Sec 27
 T1N, R10E, WM
 Water from Springs
 claimed by
 Josephine Vauthiers
 Scale: 1 inch = 200'

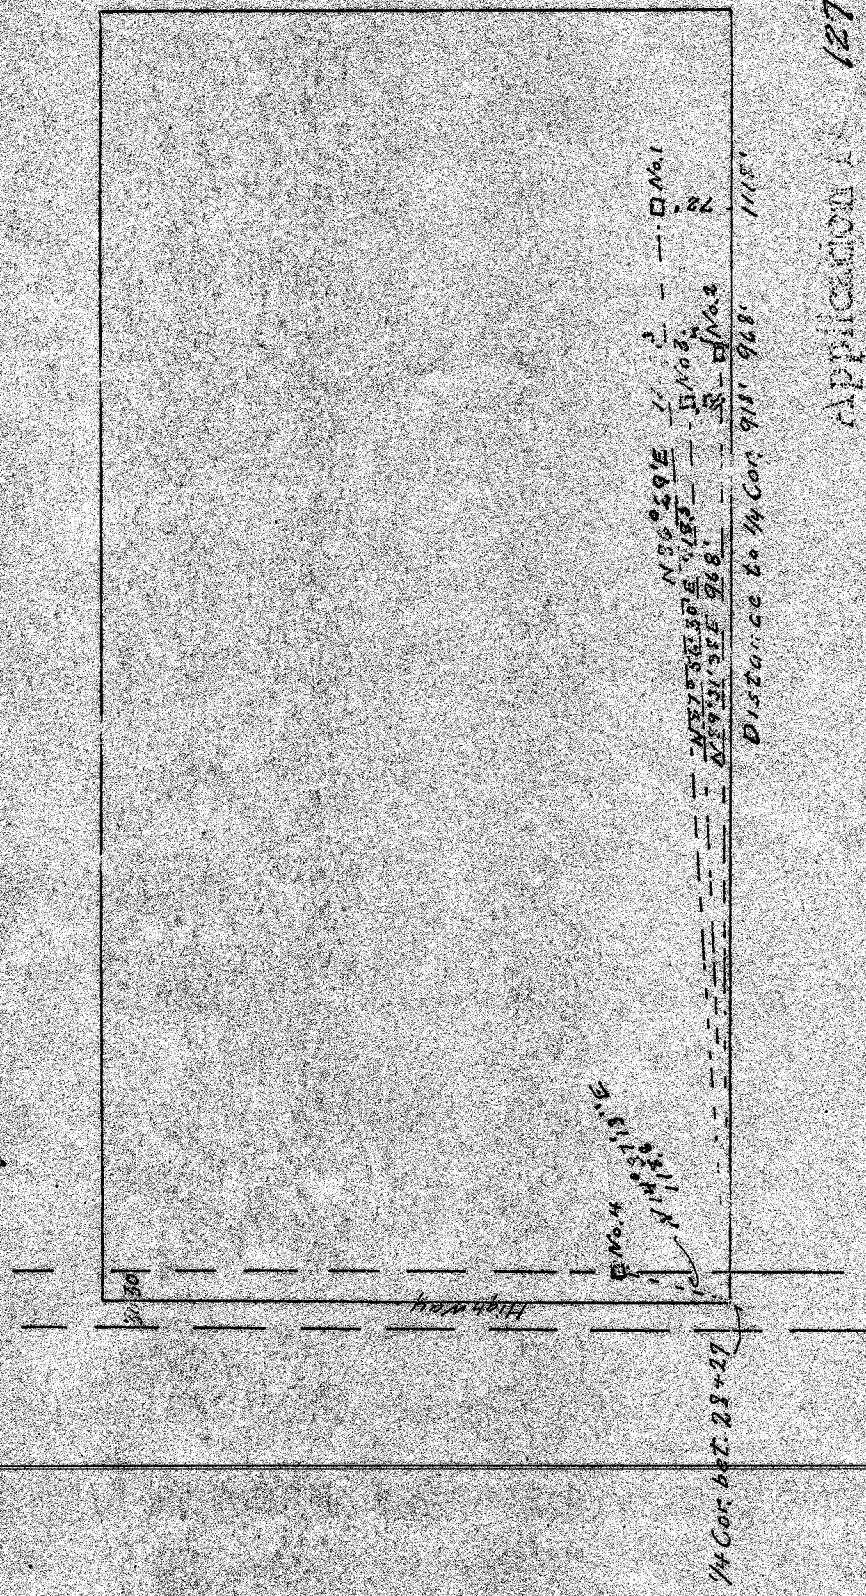

APPLICATION 12722
 PERMIT NO 9052