


Plat for Final Proof App 12878 Per 9177
Noah Chandler Phoenix Oregon
March 9th 1933.

T38S. R1W. W.M.

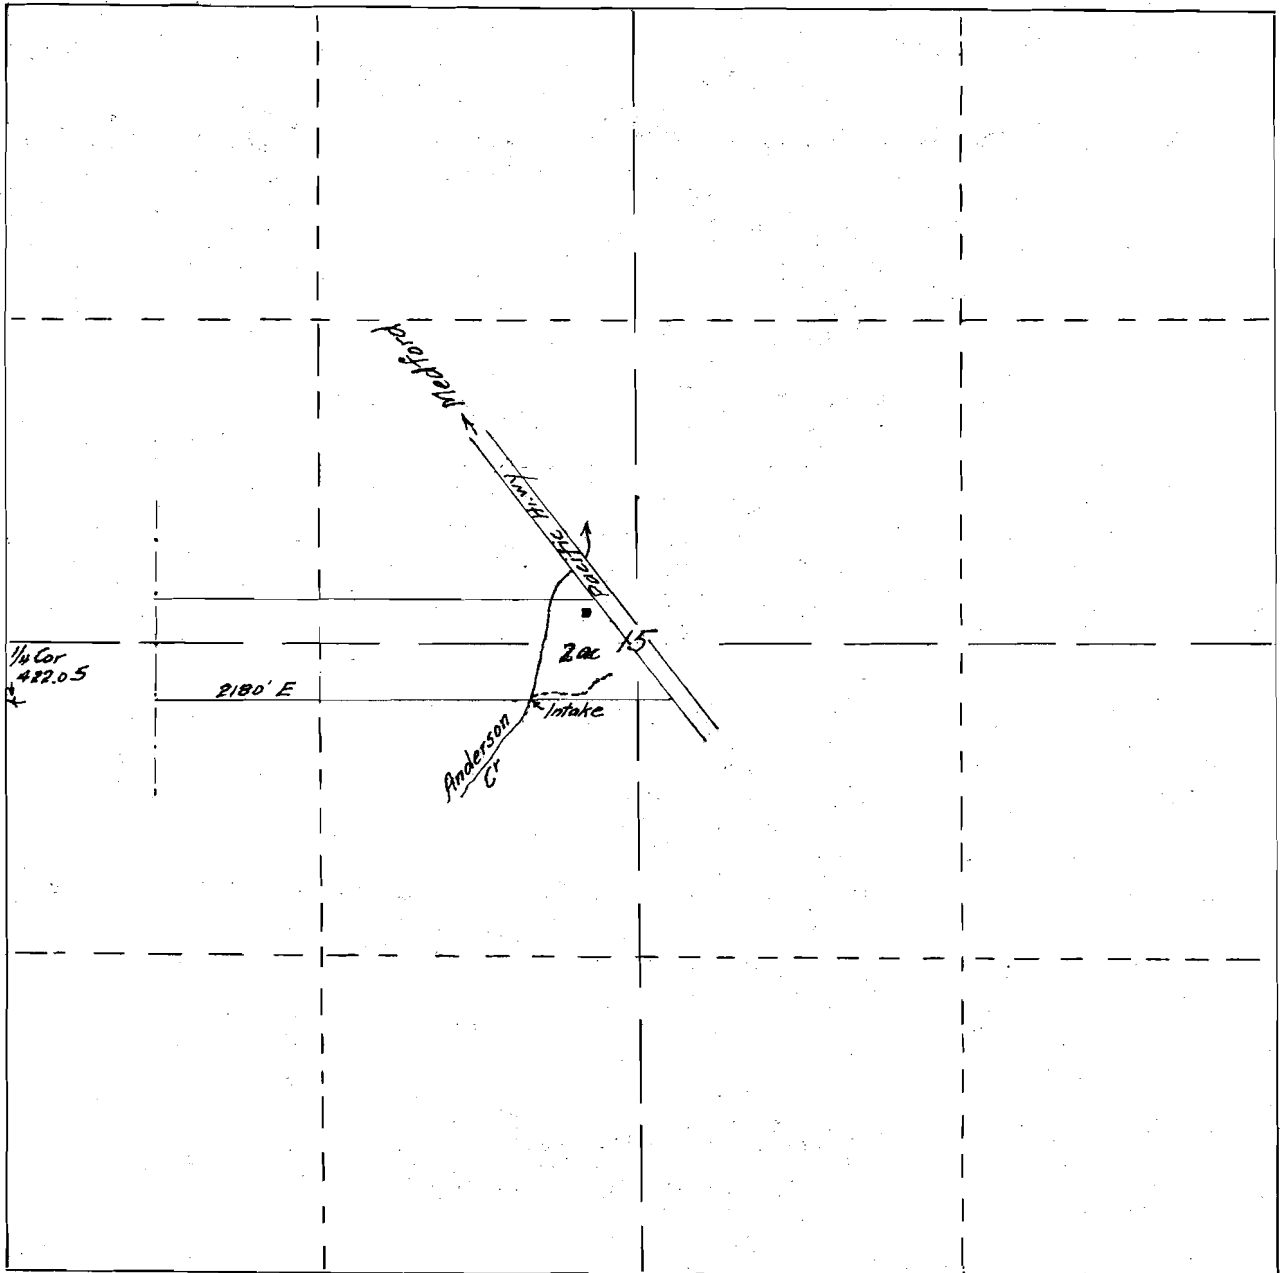

Fred N Cummings
Watermaster Dist 15.